

PIAT OF SURVEY
OF

LOT 17, WM. ELLIOTT'S POWERS LAKE SUBDIVISION, AND PART OF LOT 14 OF WM. ELLIOTT'S POWERS LAKE SUBDIVISION DESCRIBED AS FOLLOWS: COMMENCE AT THE NORTHWEST CORNER OF SAID LOT 17, THENCE N. $29^{\circ}50'$ E., 6.00 FEET; THENCE S. $70^{\circ}10'$ E., 149.20 FEET TO PUBLIC ROAD; THENCE S. $29^{\circ}50'$ W., 6.00 FEET; THENCE NORTHWESTERLY TO THE PLACE OF BEGINNING. SAID LANDS ARE LOCATED IN THE NORTHEAST FRACTIONAL 1/4 OF SECTION 13, T. 1 N., R. 18 E. OF THE 4TH P.M., TOWNSHIP OF BLOOMFIELD, COUNTY OF WALWORTH, STATE OF WISCONSIN.

FOR: RUTH MURASKAS

SCALE 1" = 30

O = IRON PIPE STAKE SET

σ = IRON PIPE STAKE POUND

• = CONCRETE MONUMENT FOUND

=IRON STAKE FOUND OVER BURIED STONE MONUMENT FOUND.



\diamond = SPIKE IN TREE ROOT.

BEARINGS RELATE TO LAKE ST. WHICH WAS USED AS
PLATTED AS S. $70^{\circ}15'$ E.

We have surveyed the above described property and the map hereto is a true representation thereof and shows the size and location of the property as exterior boundaries, the location and dimensions of all visible structures thereon, fences, apparent easements and roadways, and visible encroachments, if any.

This survey is made for the purpose of
the present owners of the property and also
those who purchase, making a guarantee
the title thereto, within one year from date
hereof.

Dated at Burlington, this 27th day
of JUNE 1884
John F. Dwyer
John F. Dwyer, Land Surveyor 242

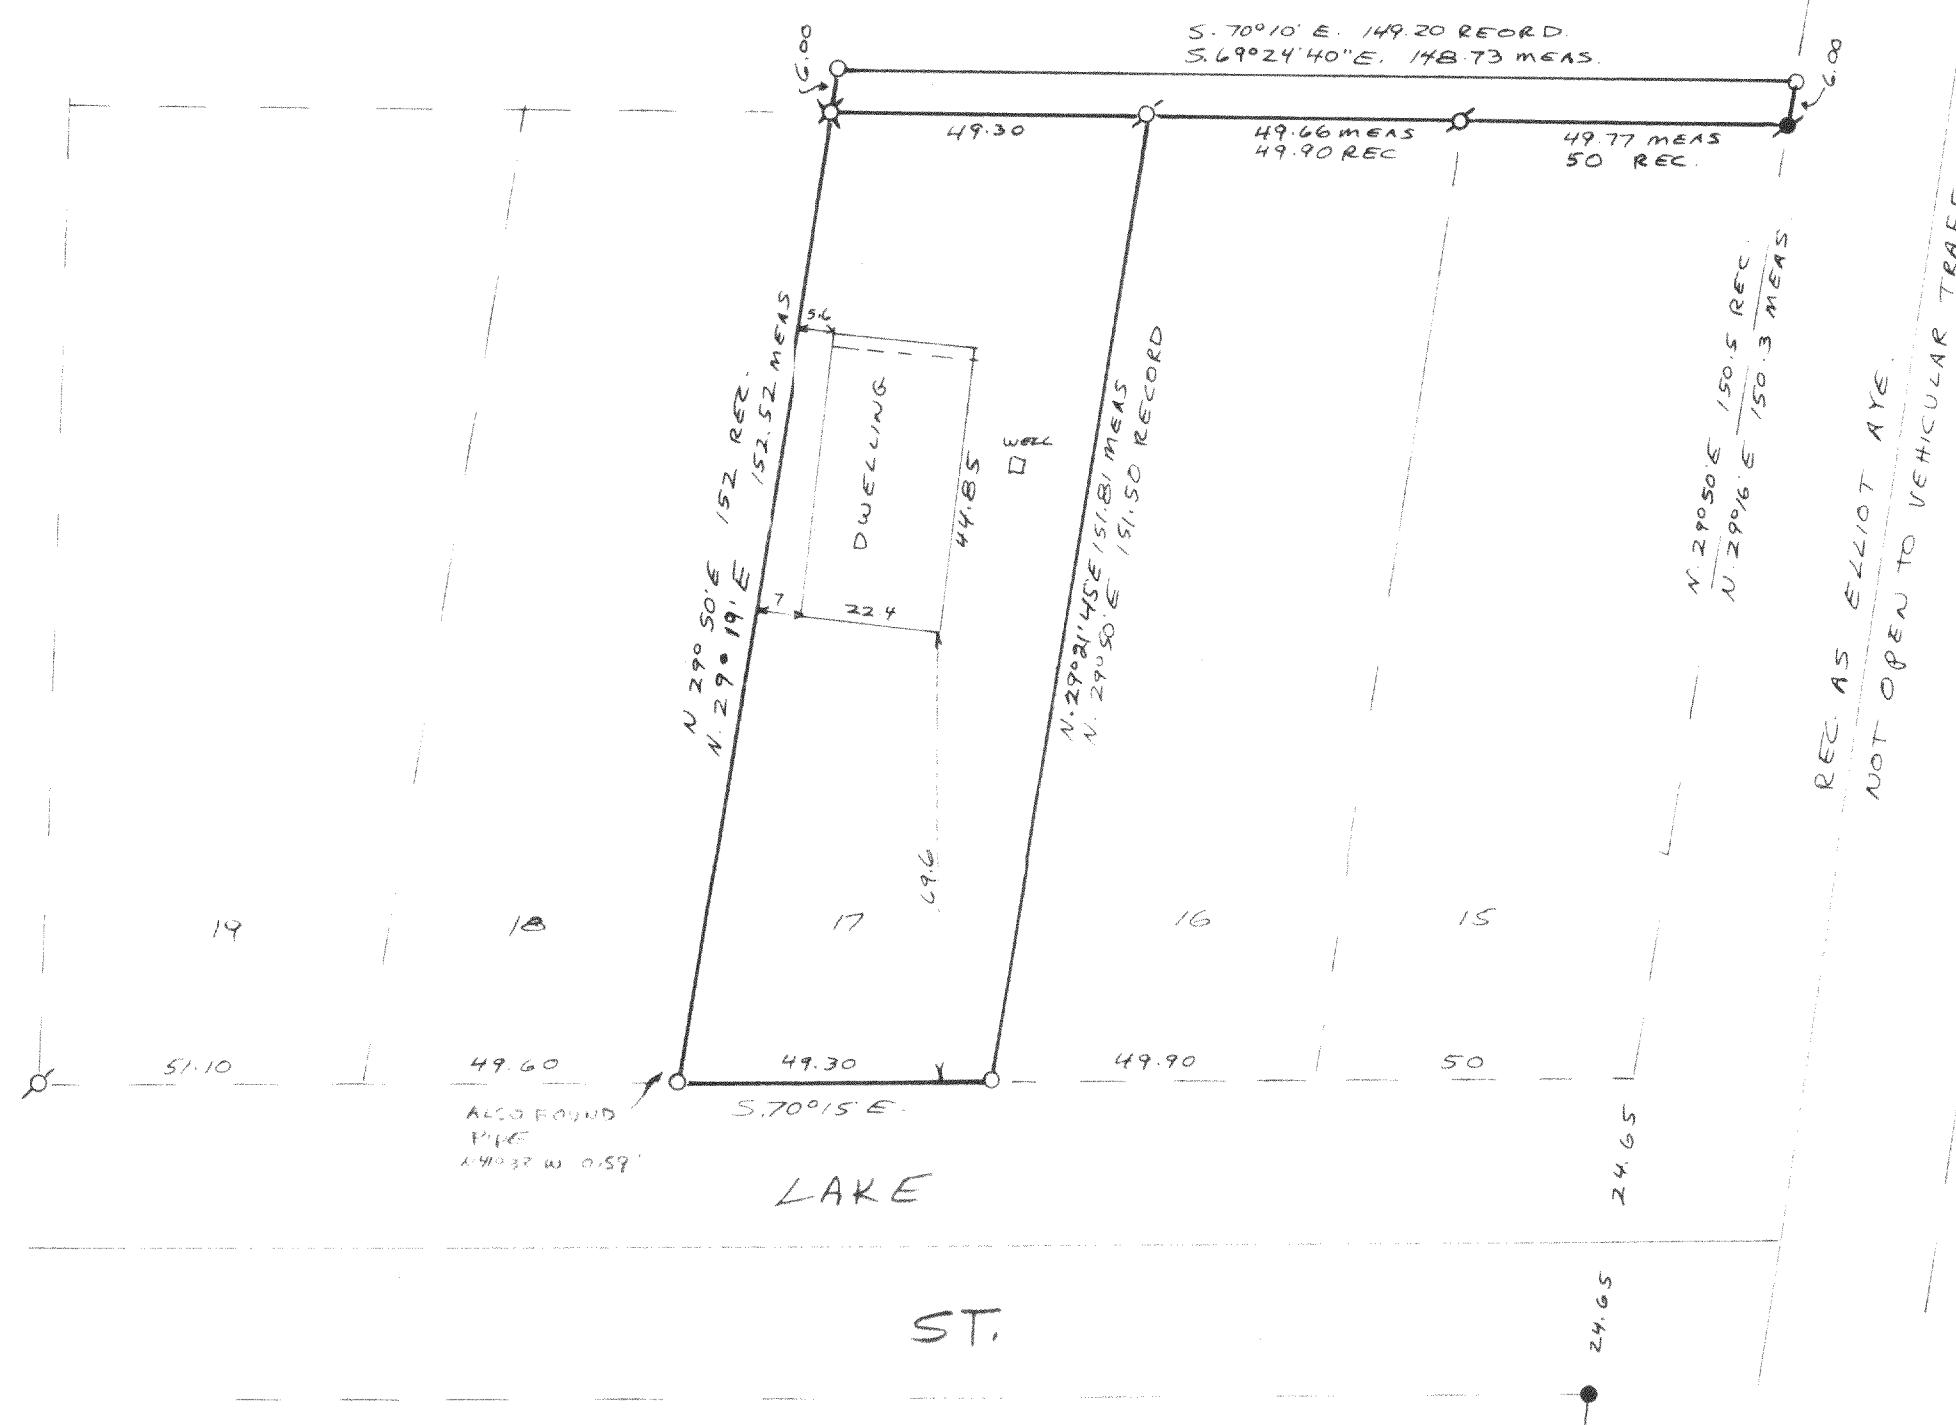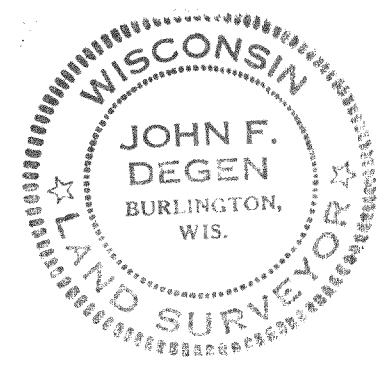

118-660

1. *Alb. 2. *Alb. 3. *Alb.***