




WALWORTH COUNTY
SURVEYING & MAPPING
LAKE GENEVA, WISCONSIN

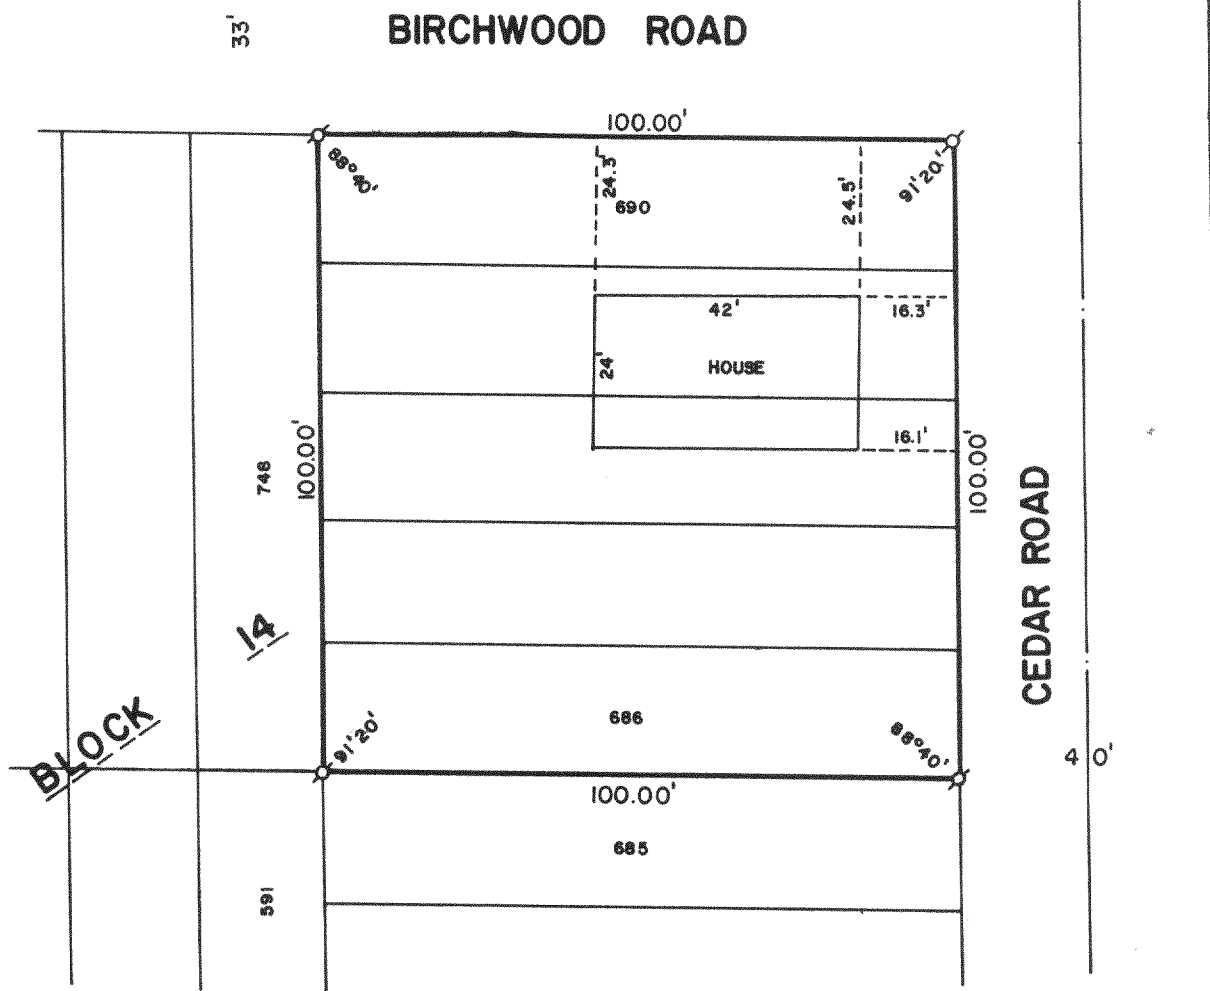

PLAT OF SURVEY OF

LOTS 686-690, BLOCK 14 OF PELL LAKE
HIGHLANDS, A SUBDIVISION LOCATED IN
SECTION 16, T 1 N, R 18 E, WALWORTH
COUNTY, WISCONSIN.

ORDERED BY: TIM ALLEN
1045 MOBILE, APT. 6
LAKE GENEVA, WISCONSIN 53147

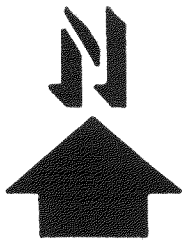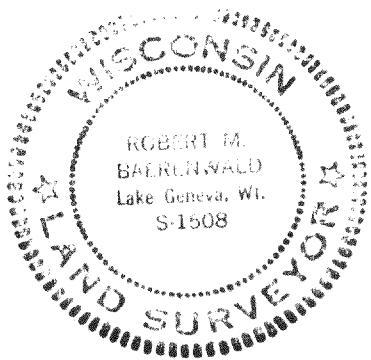

SCALE: 1"=30'

Ø - IRON PIPE FOUND

I, ROBERT M. BAERENWALD, DO HEREBY CERTIFY THAT I
HAVE SURVEYED THE PROPERTY HEREON DESCRIBED ACCORDING
TO THE OFFICIAL RECORDS AND THAT THE PLAT HEREON IS A
CORRECT REPRESENTATION OF THE PROPERTY LINES TO THE
BEST OF MY KNOWLEDGE AND BELIEF.

Robert M. Baerenwald
ROBERT M. BAERENWALD
WISCONSIN REGISTERED LAND SURVEYOR, S-1508

Nov. 12, 1984
DATE JOB NO. 0149

REVISED: JANUARY 15, 1985

118-663-B