



WALWORTH COUNTY
SURVEYING & MAPPING
LAKE GENEVA, WISCONSIN

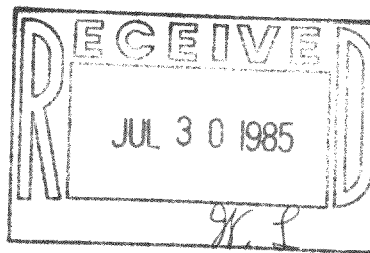

FLORENCE ROAD



50' WIDE

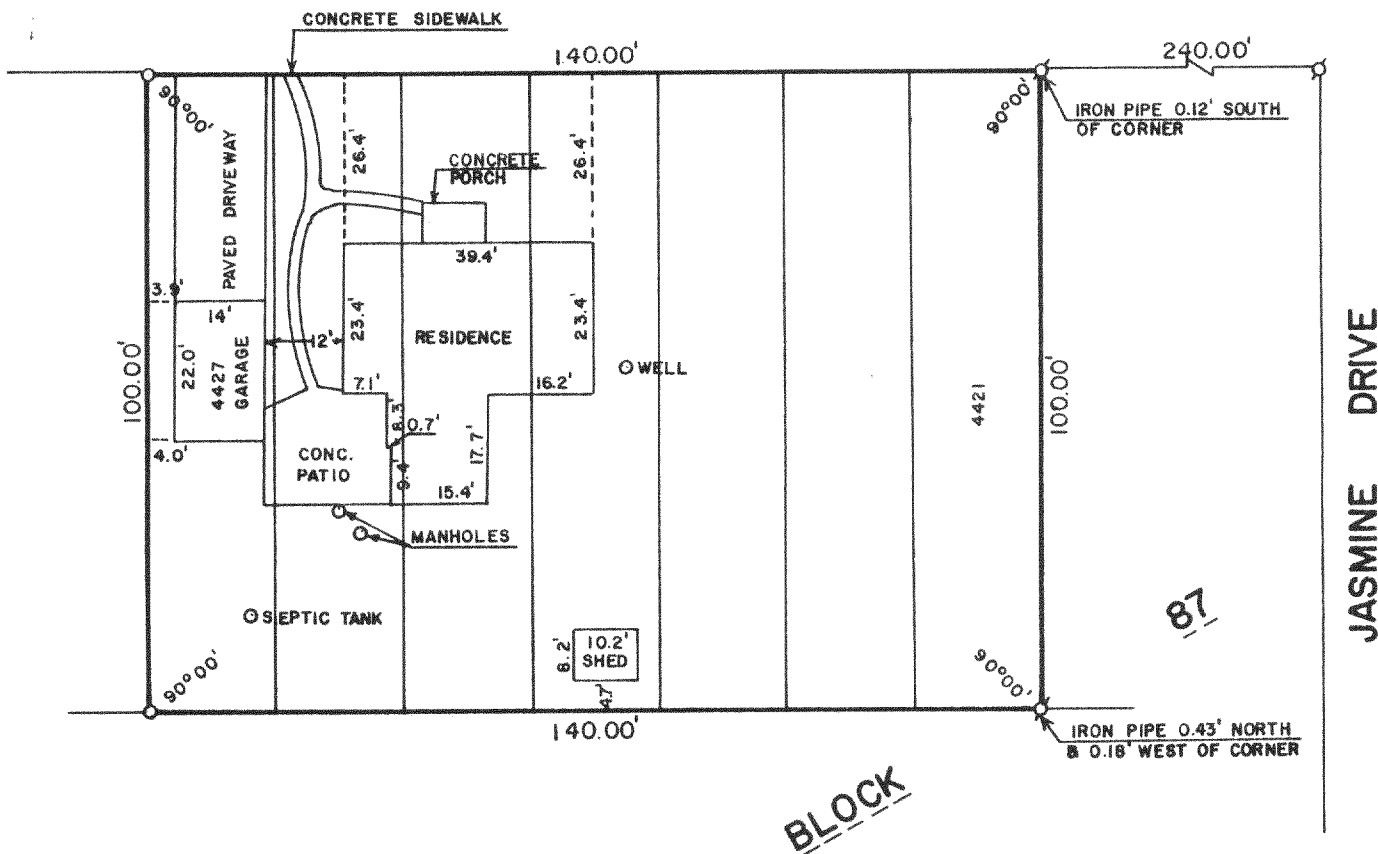

PLAT OF SURVEY OF

LOTS 4421-4427 BLOCK 87, PELL LAKE SUBDIVISION,
SECTION 3, LOCATED IN SECTION 15, T 1 N, R 18 E,
WALWORTH COUNTY, WISCONSIN.

ORDERED BY: CENTURY 21 BOULEVARD REALTY
421 BROAD STREET
LAKE GENEVA, WISCONSIN.

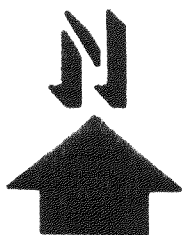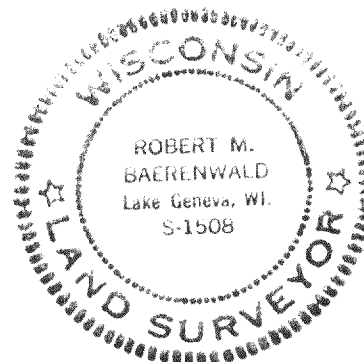

SCALE: 1"=30'

⊗ - IRON PIPE FOUND
○ - IRON PIPE PLACED

I, ROBERT M. BAERENWALD, DO HEREBY CERTIFY THAT I
HAVE SURVEYED THE PROPERTY HEREON DESCRIBED ACCORDING
TO THE OFFICIAL RECORDS AND THAT THE PLAT HEREON IS A
CORRECT REPRESENTATION OF THE PROPERTY LINES TO THE
BEST OF MY KNOWLEDGE AND BELIEF.

Robert M. Baerenwald
ROBERT M. BAERENWALD
WISCONSIN REGISTERED LAND SURVEYOR, S-1508

DATE June 18, 1984

JOB NO. 0073

118-667-B