

PLAT OF SURVEY
OF

LOT 15, IN BLOCK 2, OF NIPPERSINK PARK,
BEING A SUBDIVISION IN THE NORTHEAST 1/4
OF SECTION 24, T. 1 N., R. 18 E. IN THE
TOWN OF BLOOMFIELD, WALWORTH COUNTY, WI.

FOR: JEFF BENDIX

SCALE 1" = 50'

○ = IRON PIPE STAKE SET.



⊙ = IRON PIPE STAKE FOUND.

BEARINGS RELATE TO THE DATUM USED
IN RECORDED PLAT OF NIPPERSINK PARK.

I have surveyed the above-described property,
and the map hereon is a true representation
thereof and shows the size and location of the
property, its exterior boundaries, the location
and dimensions of all visible structures thereon,
fences, apparent easements and roadways and
visible encroachments, if any.

This survey is made for the exclusive use of
the present owners of the property, and also
those who purchase, mortgage, or guarantee
the title thereto, within one year from date
hereof.

Dated at Burlington, this 3RD. day
of APRIL 1985
John F. Degen
John F. Degen, Land Surveyor S 242

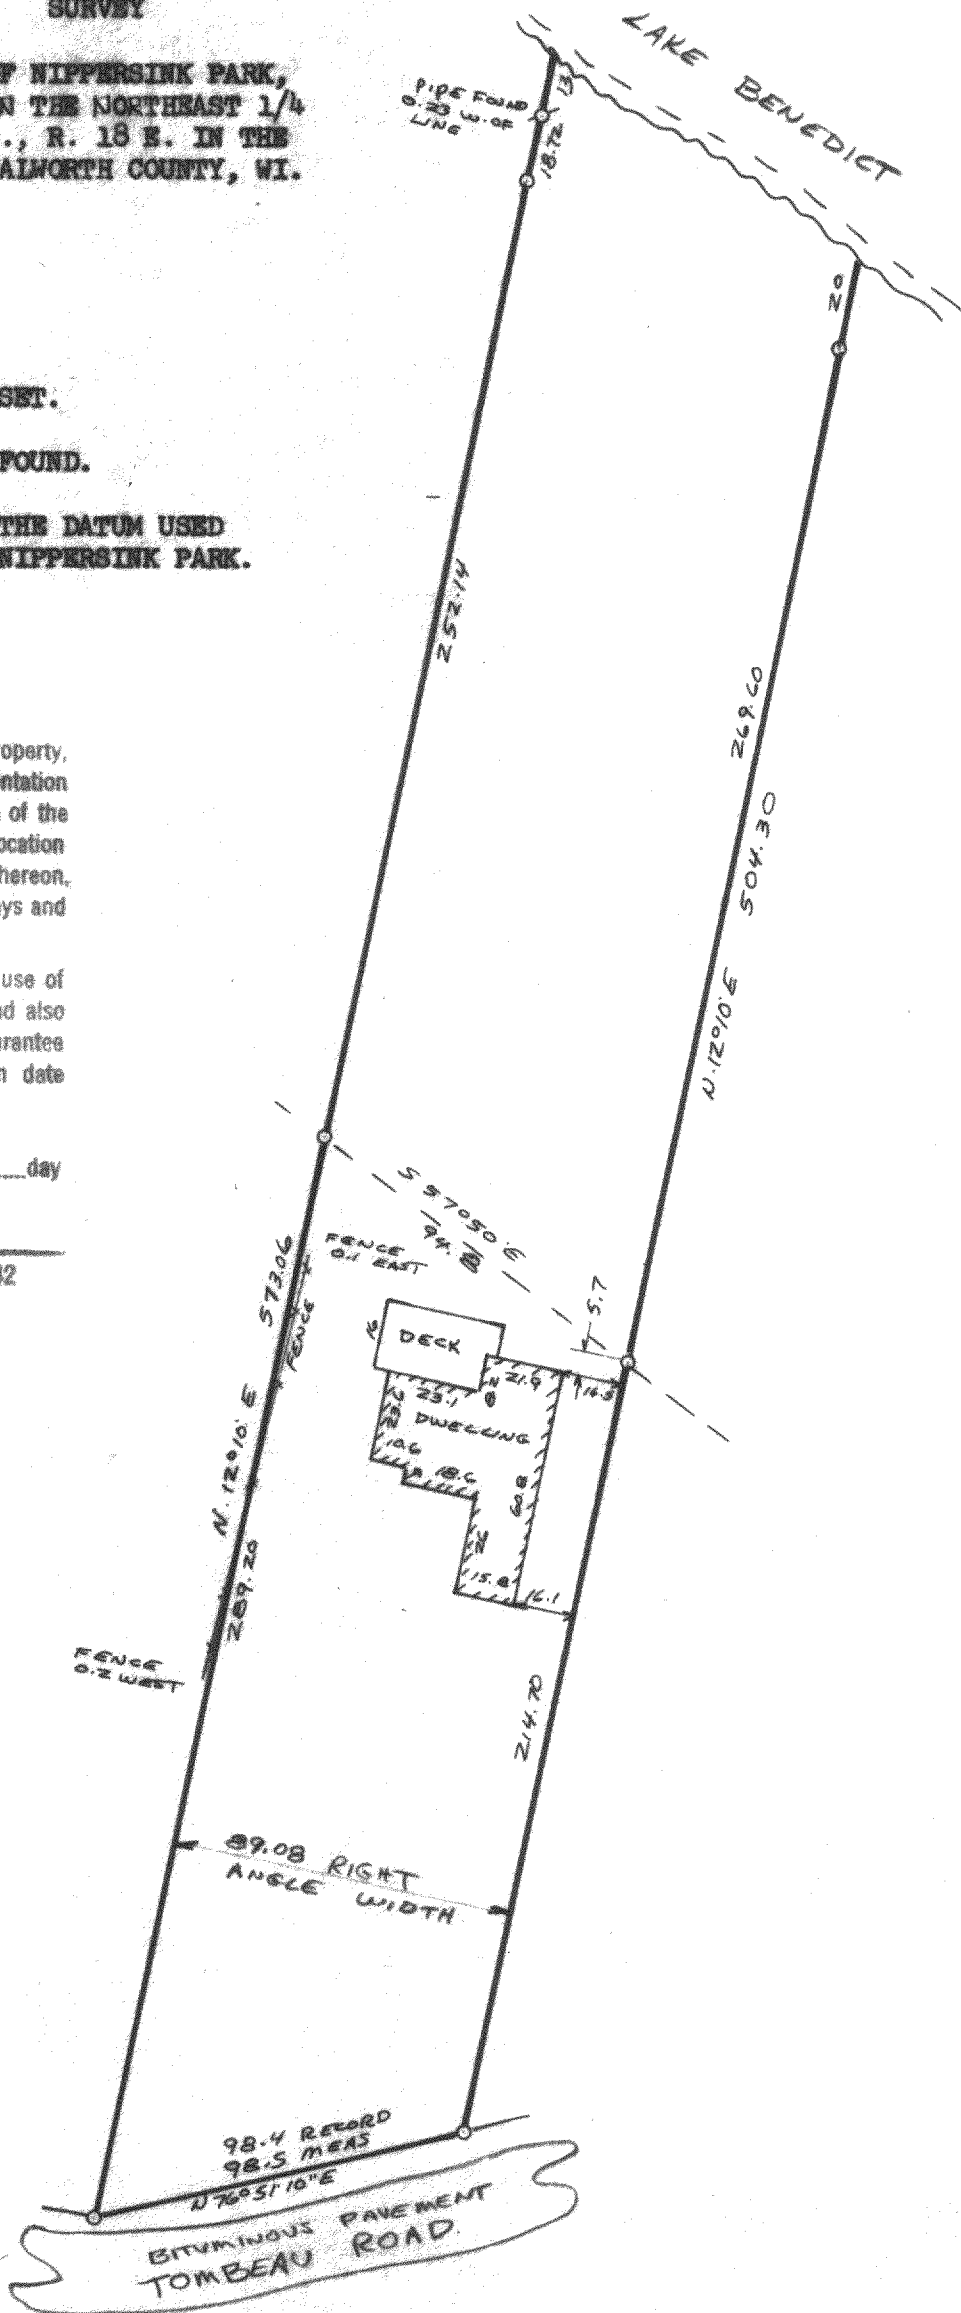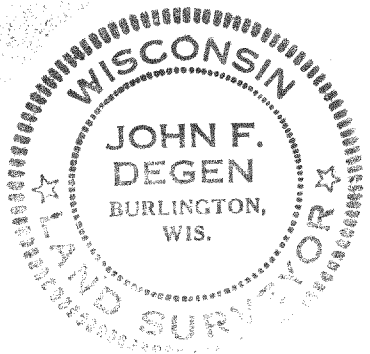

118-668✓

MNP-21

14-C #34