

PLAT OF SURVEY
OF


LOT 10, BLOCK 3, PART ONE OF THE FIRST ADDITION TO JEFFERSON ISLAND SUBDIVISION,
LOCATED IN THE SOUTHEAST 1/4 OF SECTION 13, T. 1 N., R. 18 E. OF THE 4TH P.M.
TOWNSHIP OF BLOOMFIELD, COUNTY OF WALWORTH, STATE OF WISCONSIN.

I HEREBY CERTIFY THAT I HAVE SURVEYED THE LAND DESCRIBED ABOVE AND THAT THE
PLAT DRAWN HEREON IS A CORRECT REPRESENTATION OF SAID SURVEY.

John F. Degen
JOHN F. DEGEN, LAND SURVEYOR #242
589 N. PINE ST., BURLINGTON, WISCONSIN.

RE-SURVEY 7-26-85



11-27-73

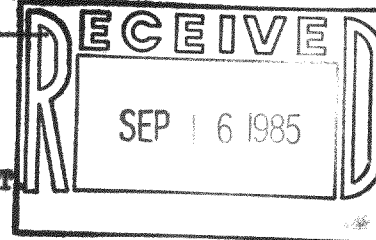

SCALE 1" = 40'

o = IRON PIPE STAKE FOUND.

LAND SURVEYED IS VACANT

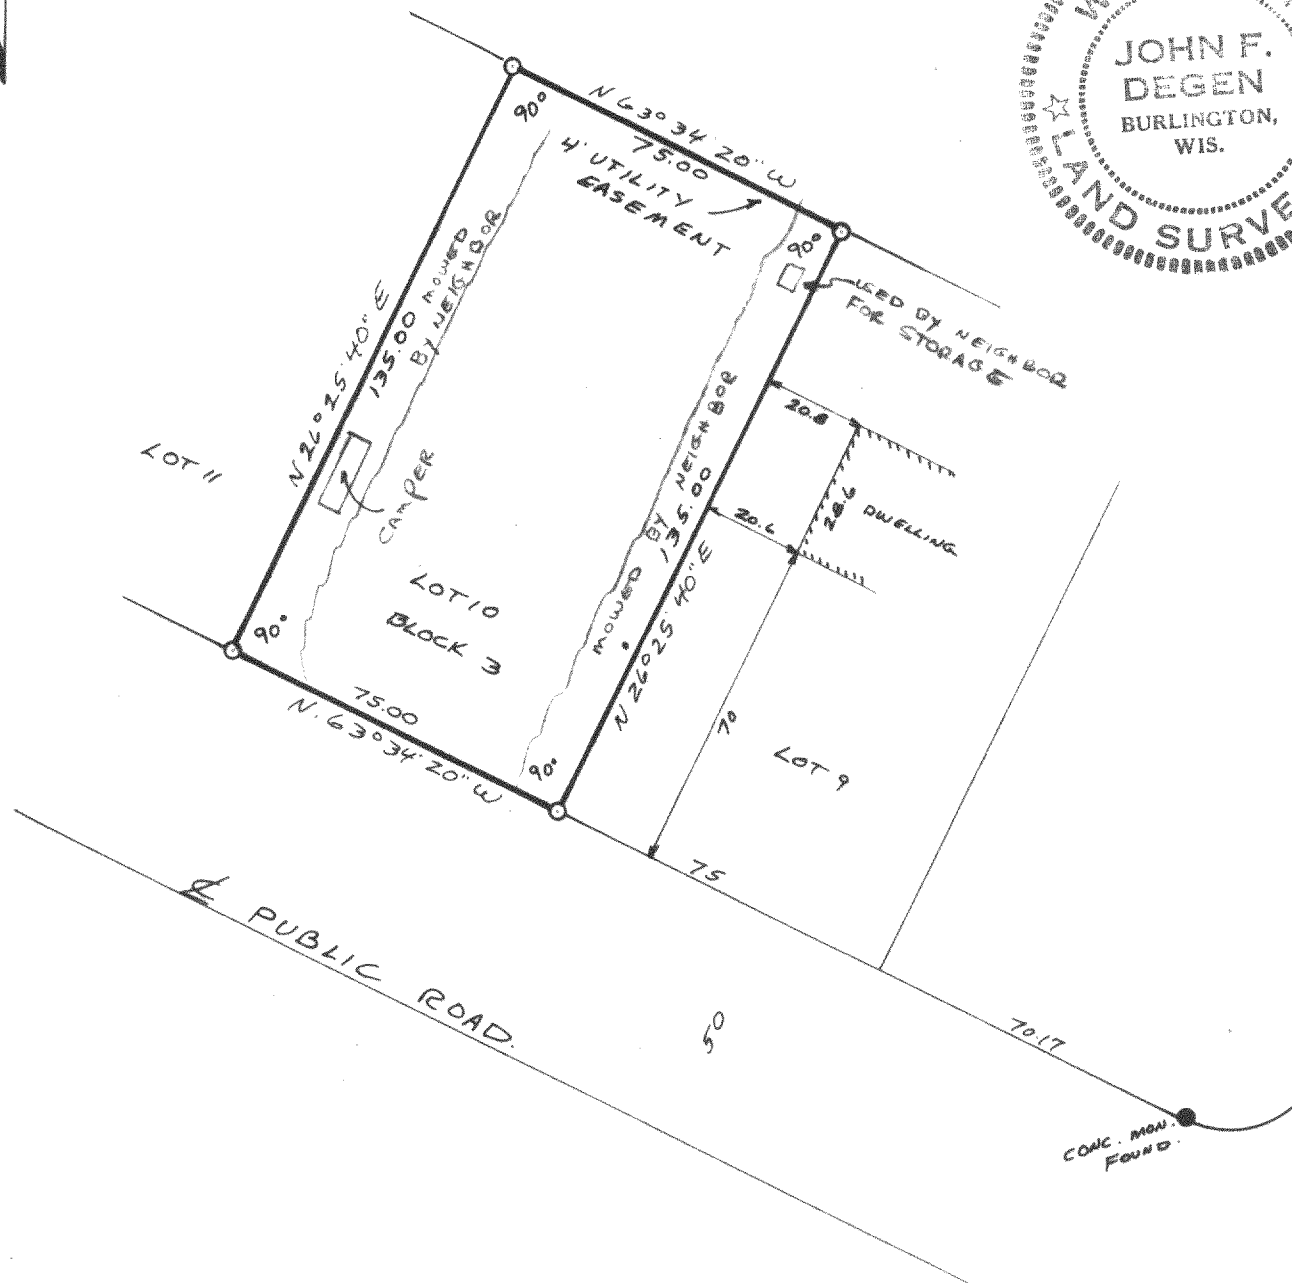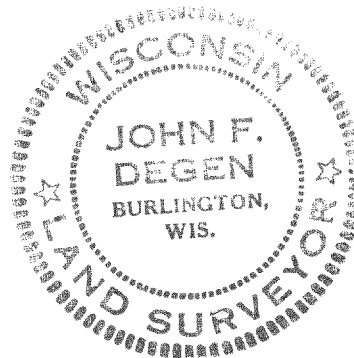

CONC. MARK FOUND

118-670-D