

NW. Cor. Blk. 22

PLAT OF SURVEY

Of Lots 1482- 1488 Inclusive, and Lots 1476 - 1478 Inclusive and the SOUTH 40' of
Lots 1452 and 1453, all of Block 24, PELL LAKE ADDITION, WALWORTH COUNTY, WISCONSIN.

SE. Cor. Blk. 20

2" FIP is 0.49' East

WEST 700.00'

SW. Cor. Blk. 22

WISTERIA 40' WIDE

EAST 700.00'

Subd. Data- Cab. 1 Slide 100
Vol. 8 P. 29 of Plats
June 10, 1925

NE. Cor. Blk. 24

Property is fenced
entirely


24

Owner- Vince Domino
1292 Daisy Dr.
Pell Lake, Wis.
Ordered by- Architect Richard Kowolski
Lake Geneva, Wis.

I hereby certify that I have surveyed the above
described property, that the plat shown hereon
is an accurate survey, a true representation
thereof, correctly shows the exterior boundaries
, and the correct measurements thereof, and the
location of all visible structures thereon to the
best of my professional knowledge and belief.

Kenneth B. Abernathy Jr.
Kenneth B. Abernathy Jr.
Wis. Reg. Surveyor No.
S- 1594

ABERNATHY & ASSOC.
RT. 3 BOX 273
ELKHORN, WI. 53121

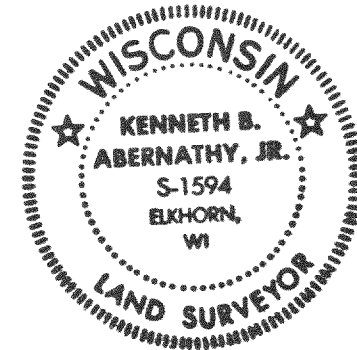


SCALE 1" = 40'

LEGEND

- ⊙ - 1 1/2" dia. iron pipe found
- ⊙ - 2" dia. iron pipe found
- - 3/4" dia. iron rod 30" long set

DAISY DR. 50' WIDE

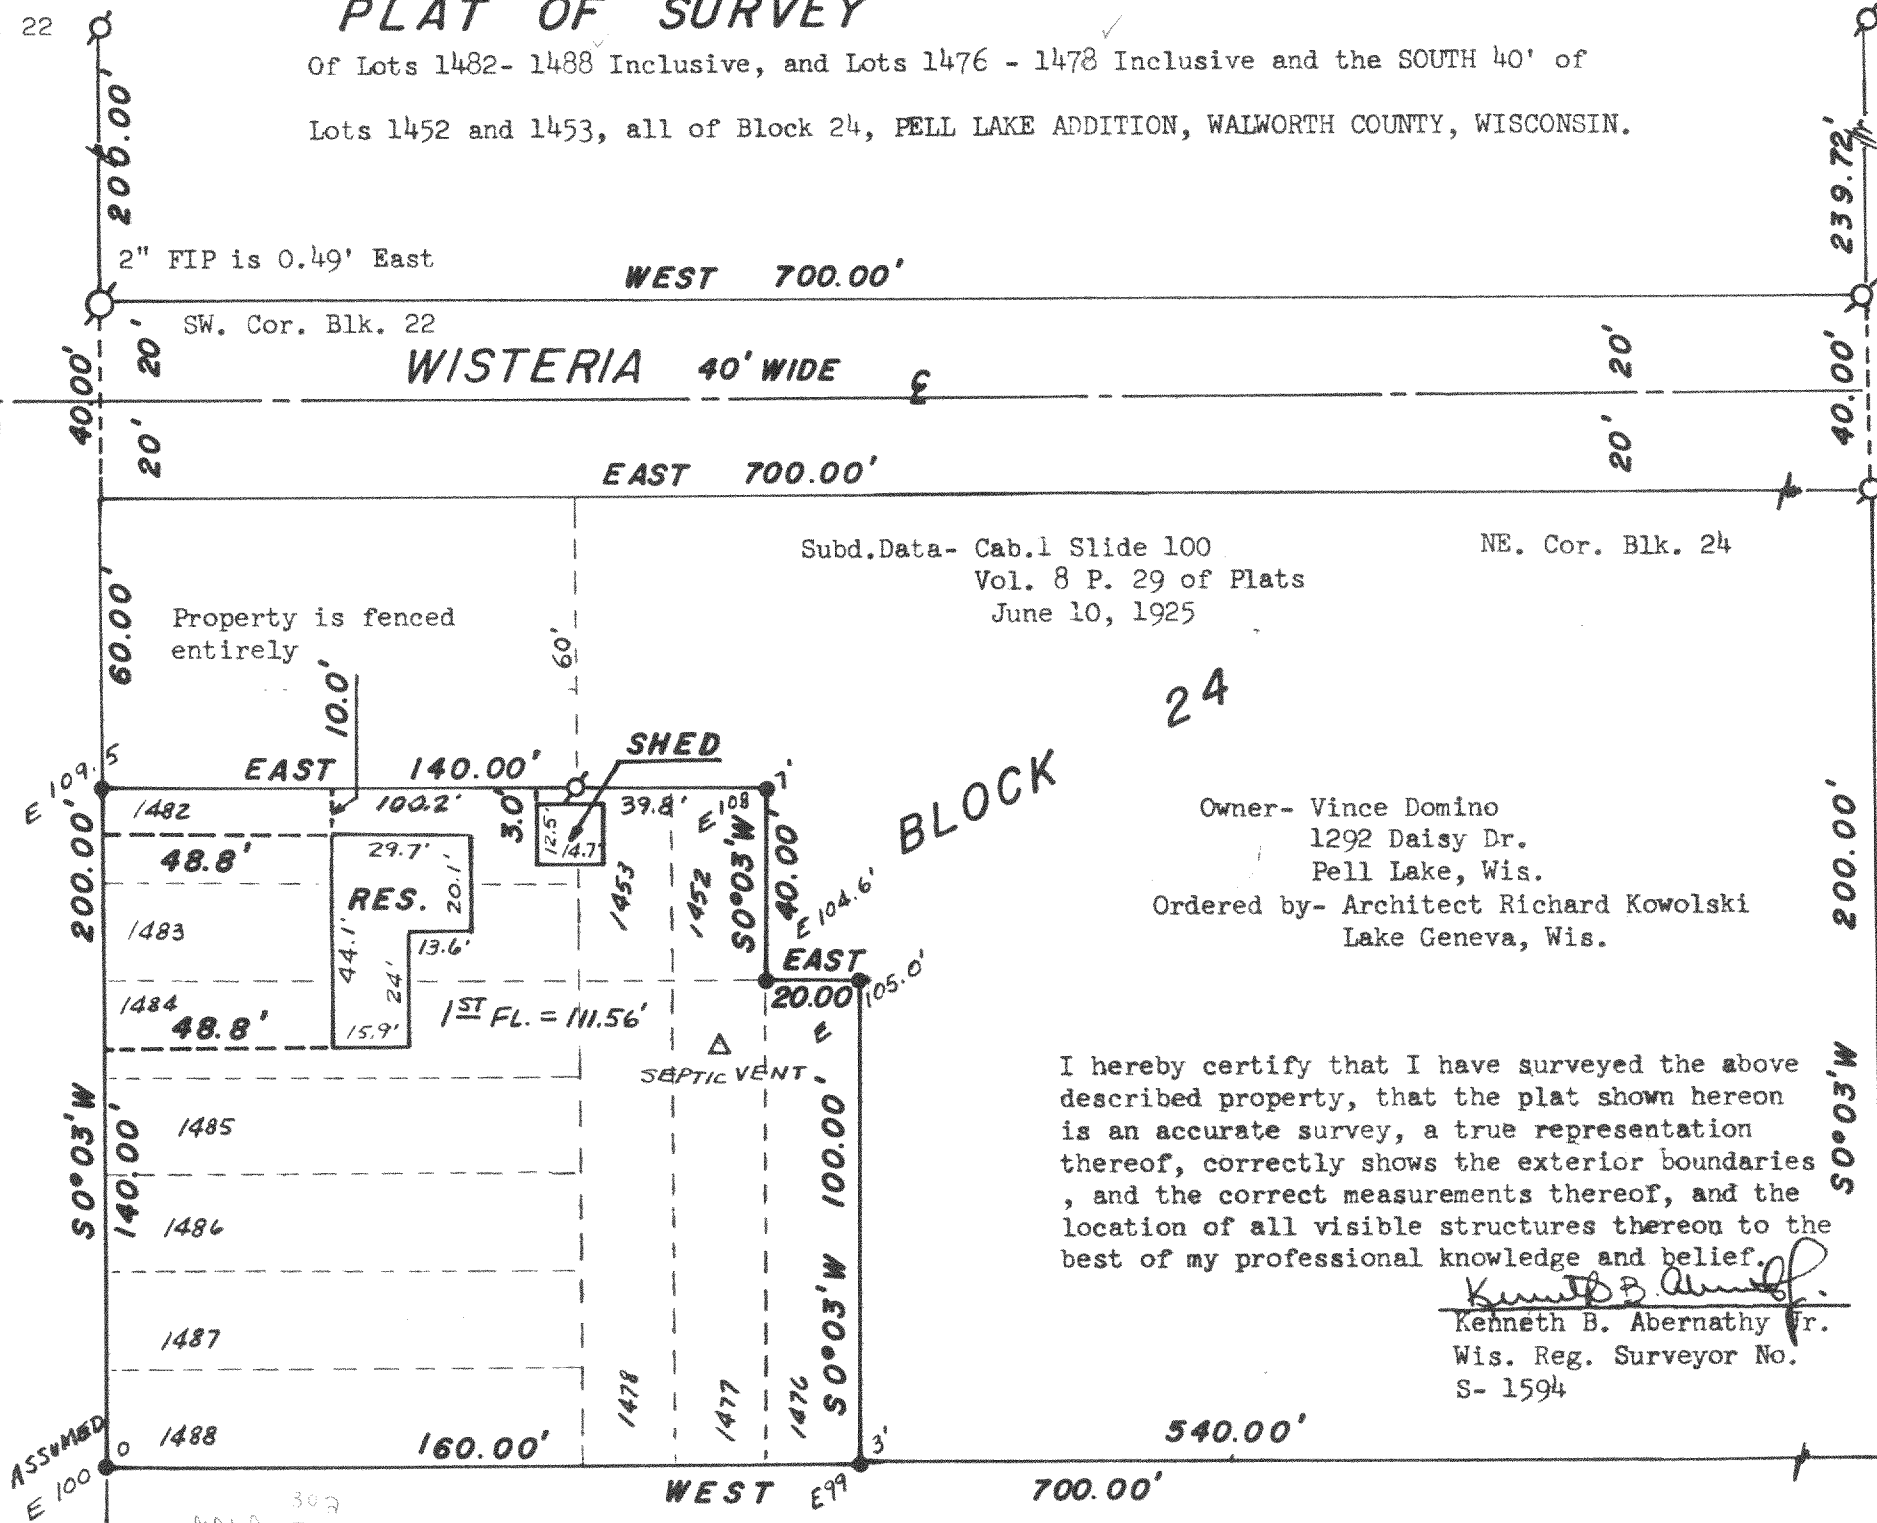

302
MPLA-309

118-671'