





WALWORTH COUNTY  
SURVEYING & MAPPING  
LAKE GENEVA, WISCONSIN

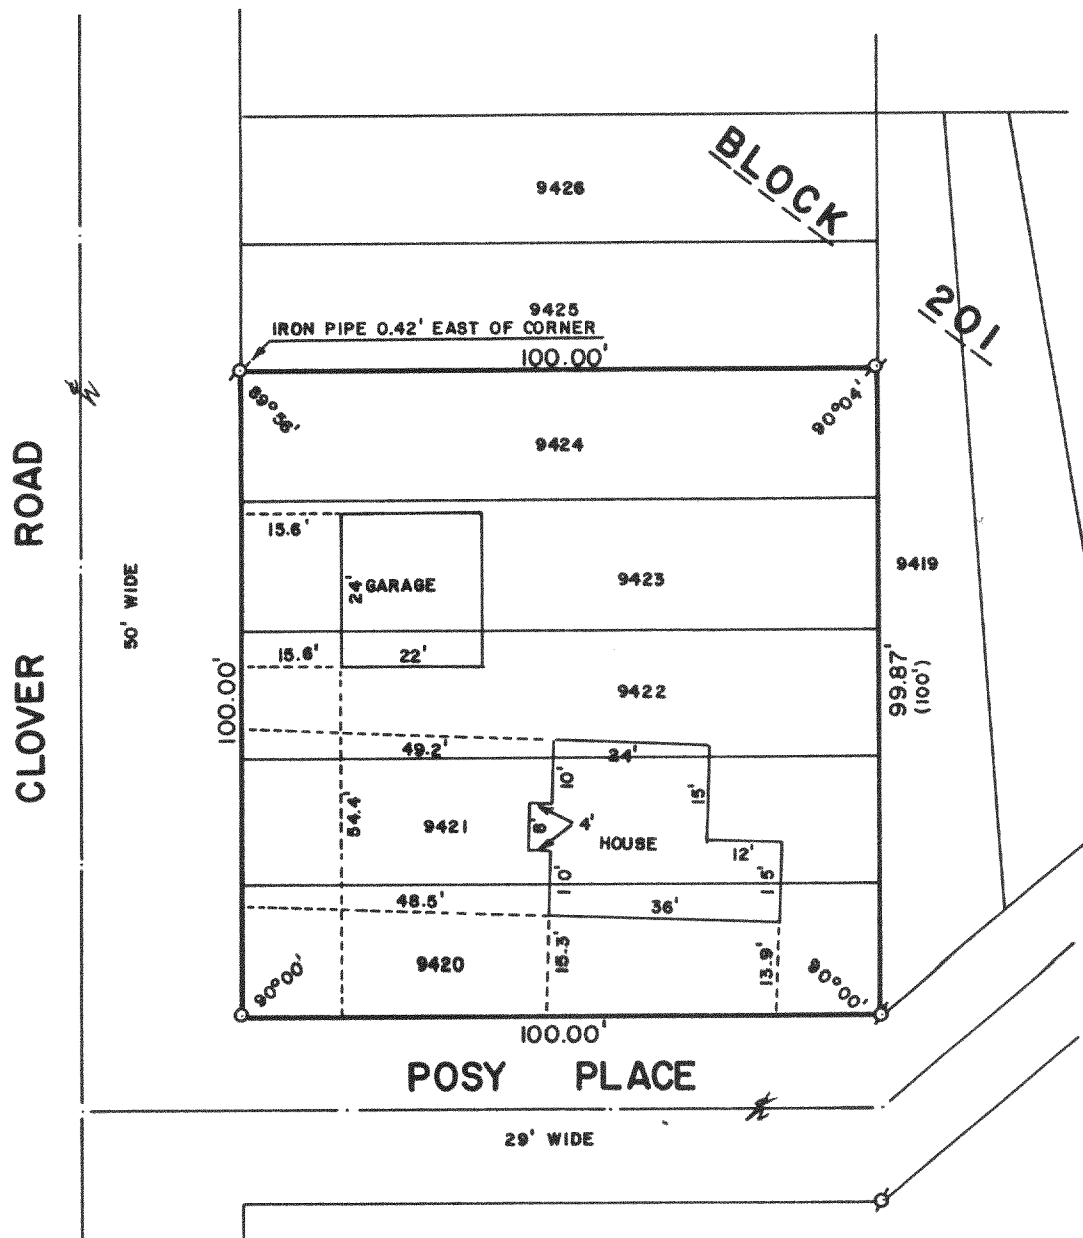

PLAT OF SURVEY OF

LOTS 9420-9424, BLOCK 201 OF SECTION  
6 OF PELL LAKE, A SUBDIVISION LOCATED  
IN SECTION 15, T 1 N, R 18 E, WALWORTH  
COUNTY, WISCONSIN.

ORDERED BY: KEEFE REAL ESTATE  
P. O. BOX 365  
DELAVER, WISCONSIN 53115

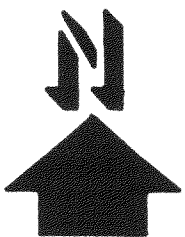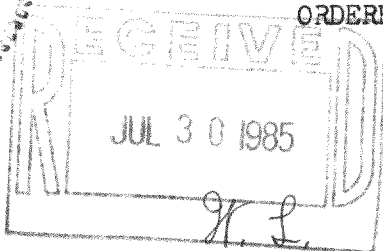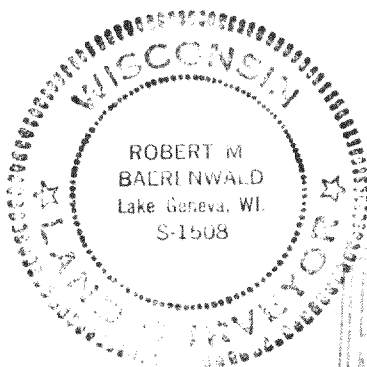

SCALE: 1"=30'

⊘ - IRON PIPE FOUND  
○ - IRON PIPE PLACED  
( ) - RECORDED AS

I, ROBERT M. BAERENWALD, DO HEREBY CERTIFY THAT I  
HAVE SURVEYED THE PROPERTY HEREON DESCRIBED ACCORDING  
TO THE OFFICIAL RECORDS AND THAT THE PLAT HEREON IS A  
CORRECT REPRESENTATION OF THE PROPERTY LINES TO THE  
BEST OF MY KNOWLEDGE AND BELIEF.

Robert M. Baerenwald  
ROBERT M. BAERENWALD  
WISCONSIN REGISTERED LAND SURVEYOR, S-1508

January 22, 1985  
DATE JOB NO. 0191

MPL-01911

118-671-R