

PLAT OF SURVEY
OF


LOTS 5688 THRU 5697 IN BLOCK 103 OF SECTION 3 OF PELL LAKE SUBDIVISION, LOCATED IN THE
SOUTHEAST 1/4 OF SECTION 15, T. 1 N., R. 18 E. OF THE 4TH P.M., TOWNSHIP OF BLOOMFIELD,
COUNTY OF WALWORTH, STATE OF WISCONSIN.

FOR: PERTELL

SCALE 1" = 30'

o = IRON PIPE STAKE SET.

φ = IRON PIPE STAKE FOUND.

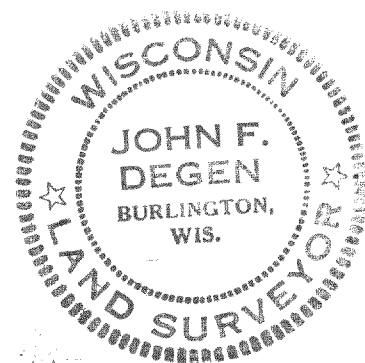


I have surveyed the above-described property,
and the map hereon is a true representation
thereof and shows the size and location of the
property, its exterior boundaries, the location
and dimensions of all visible structures thereon,
fences, apparent easements, and roadways and
visible encroachments, if any.

This map is made for the exclusive use of
the present owners of the property, and also
those who purchase, mortgage, or guarantee
the title thereto, within one year from date
hereof.

Dated at Burlington, this 25th day

June 1985
John F. Degen
John F. Degen Land Surveyor S 242

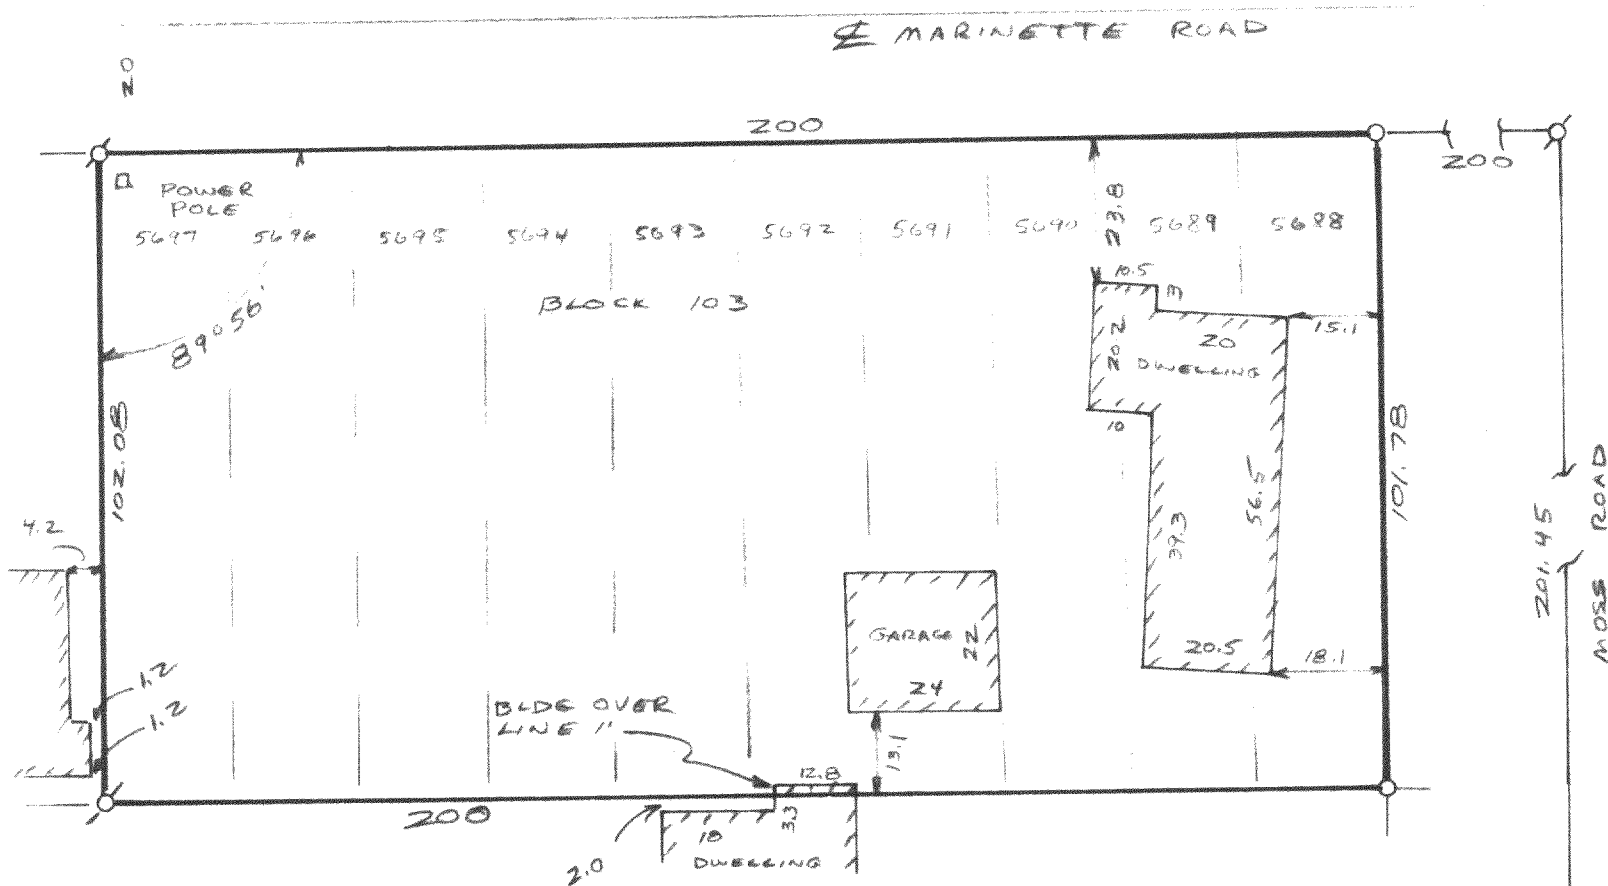

MP-1236
MP-1235

118-672