



WALWORTH COUNTY
SURVEYING & MAPPING
LAKE GENEVA, WISCONSIN


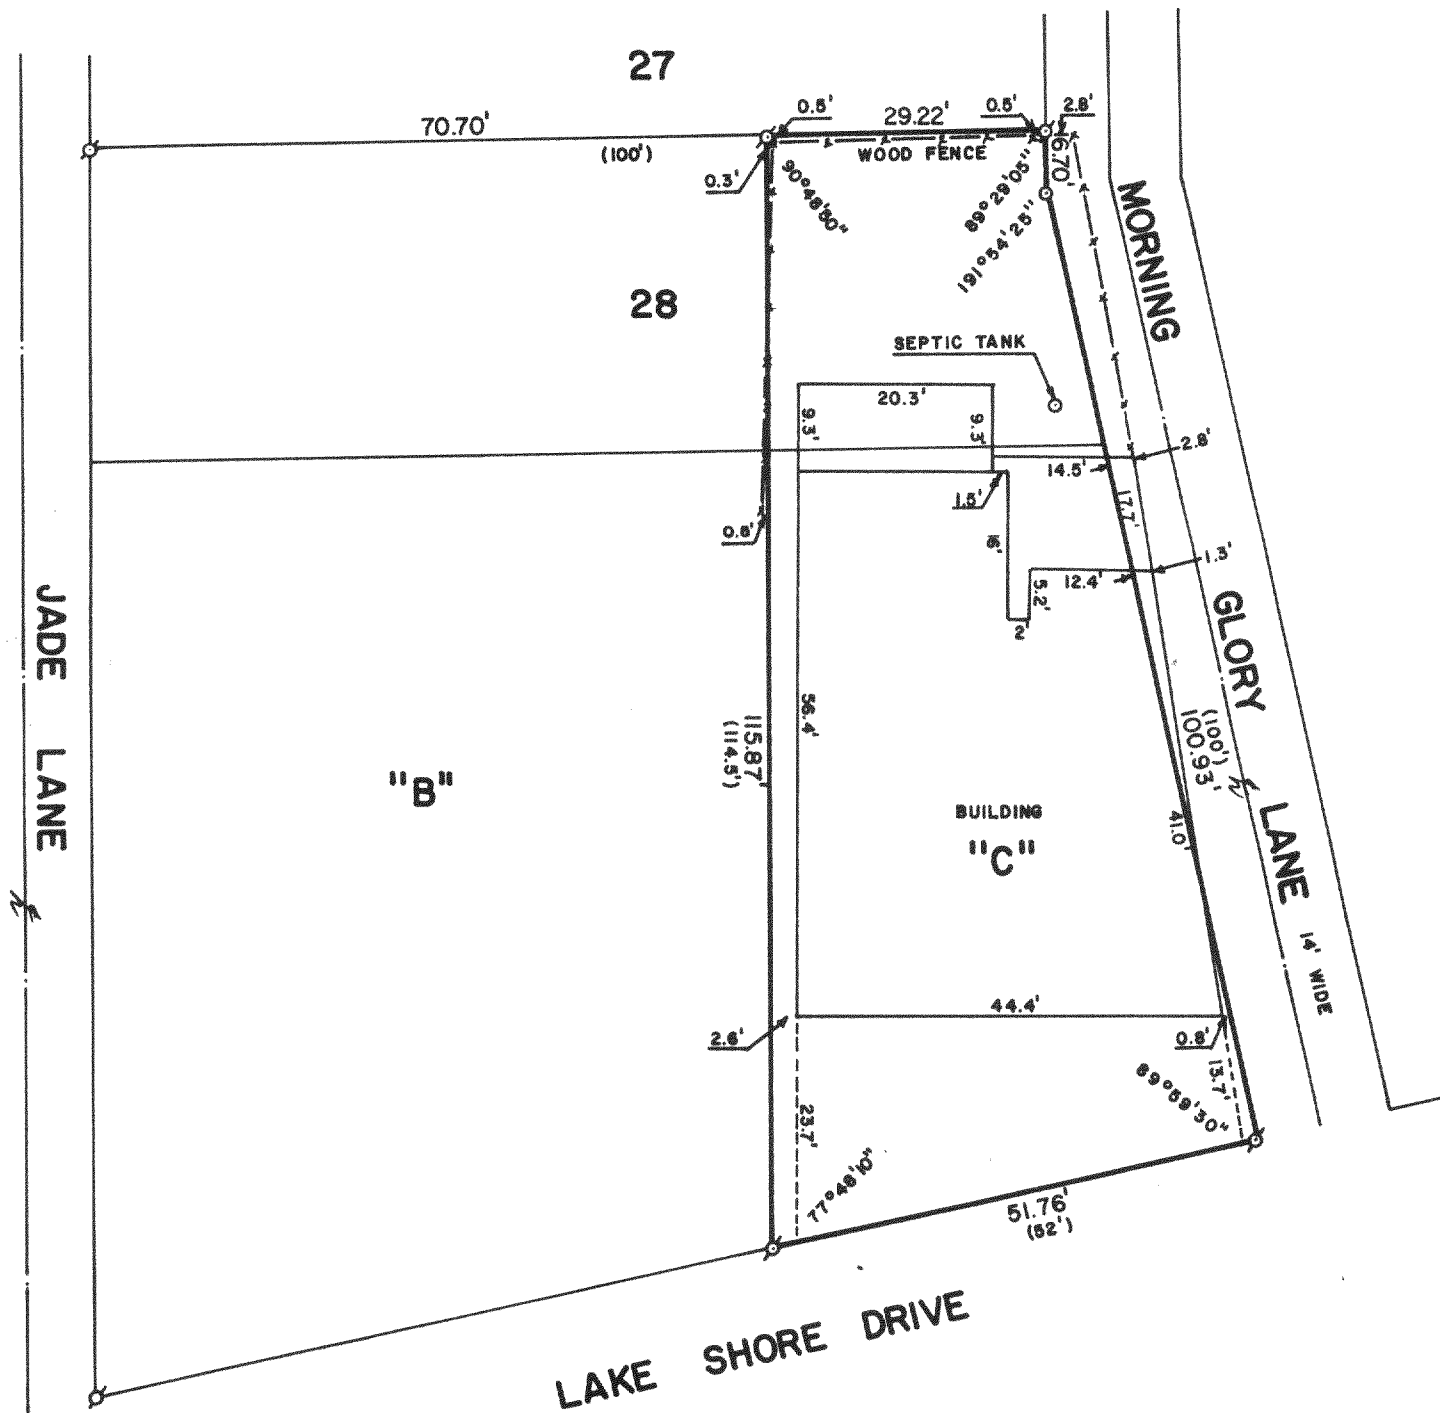


PLAT OF SURVEY OF

LOT 28 EXCEPT THE WESTERLY 70.70 FEET AND ALL
OF LOT "C" OF SITTERLE'S SUBDIVISION, T 1 N,
R 18 E, WALWORTH COUNTY, WISCONSIN

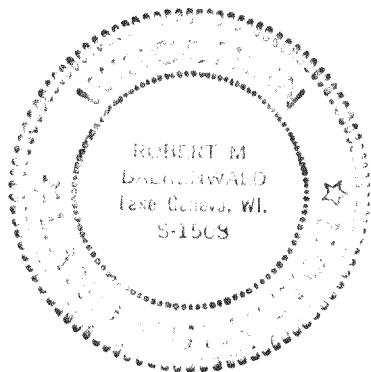

ORDERED BY: RICHARD BRUGGER
721 GENEVA STREET
LAKE GENEVA, WISCONSIN 53147

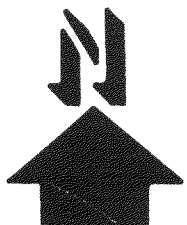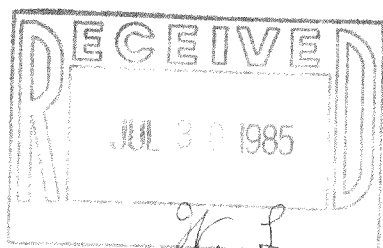

SCALE: 1"=20'

⊙ - IRON PIPE FOUND
○ - IRON PIPE PLACED
() - RECORDED AS

I, ROBERT M. BAERENWALD, DO HEREBY CERTIFY THAT I
HAVE SURVEYED THE PROPERTY HEREON DESCRIBED ACCORDING
TO THE OFFICIAL RECORDS AND THAT THE PLAT HEREON IS A
CORRECT REPRESENTATION OF THE PROPERTY LINES TO THE
BEST OF MY KNOWLEDGE AND BELIEF.

Robert M. Baerenwald
ROBERT M. BAERENWALD
WISCONSIN REGISTERED LAND SURVEYOR, S-1508

Nov. 6, 1984
DATE JOB NO. 0142

MS-12,28

118-672-B