


RECEIVED
OCT 22 1985

WALWORTH COUNTY
SURVEYING & MAPPING
LAKE GENEVA, WISCONSIN


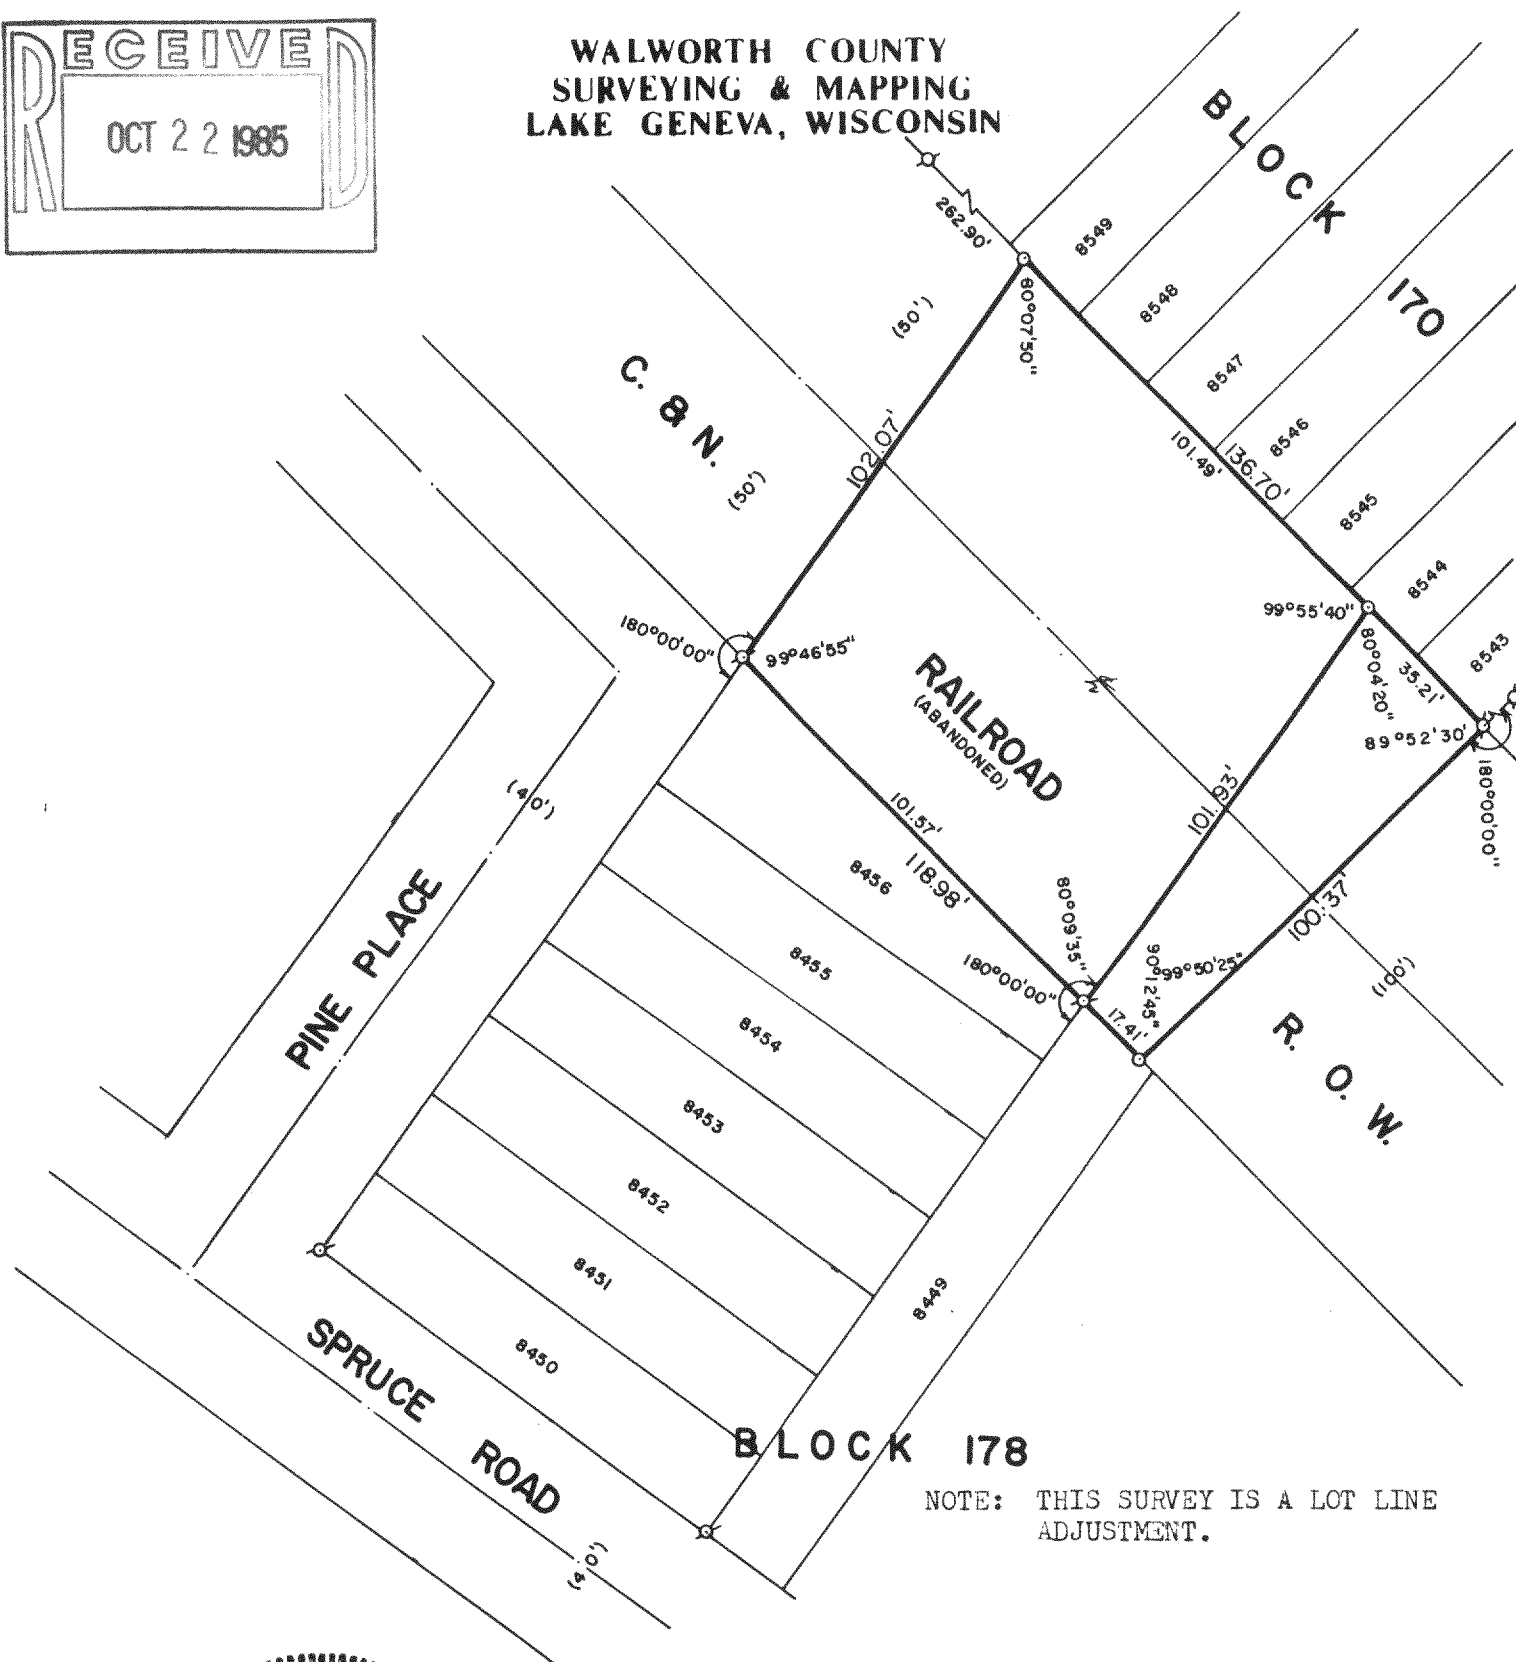


NOTE: THIS SURVEY IS A LOT LINE
ADJUSTMENT.

PLAT OF SURVEY OF

A PARCEL OF LAND LOCATED IN SECTION 22, T 1 N,
R 18 E, WALWORTH COUNTY, WISCONSIN BEING PART
OF THE ABANDONED CHICAGO & NORTHWESTERN RAILROAD
RIGHT-OF-WAY ADJACENT TO BLOCK 178 OF PELL LAKE
SUBDIVISION, SECTION 5.

ORDERED BY: RON PEO
P. O. BOX 50
PELL LAKE, WISCONSIN 53157

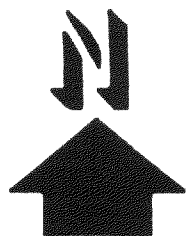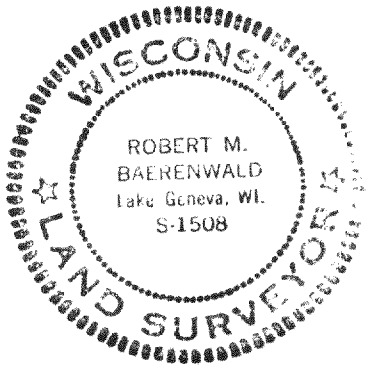

SCALE: 1"=40'

⊕ - IRON PIPE FOUND
○ - IRON ROD SET
() - RECORDED AS

I, ROBERT M. BAERENWALD, DO HEREBY CERTIFY THAT I
HAVE SURVEYED THE PROPERTY HEREON DESCRIBED ACCORDING
TO THE OFFICIAL RECORDS AND THAT THE PLAT HEREON IS A
CORRECT REPRESENTATION OF THE PROPERTY LINES TO THE
BEST OF MY KNOWLEDGE AND BELIEF.

Robert M. Baerenwald
ROBERT M. BAERENWALD
WISCONSIN REGISTERED LAND SURVEYOR, S-1508

Oct. 19, 1985
DATE JOB NO. 0356

118-3164

118-677-B