


PLAT OF SURVEY
OF

LOTS 125 THRU 131 AND LOTS 147 THRU 151 IN BLOCK 3 OF PELL LAKE ADDITION, IN THE SOUTHWEST 1/4 OF SECTION 14, T. 1 N., R. 18 E. TOWN OF BLOOMFIELD, WALWORTH COUNTY, WISCONSIN.

FOR: HOWARD

SCALE 1" = 30'



o = IRON PIPE STAKE FOUND.

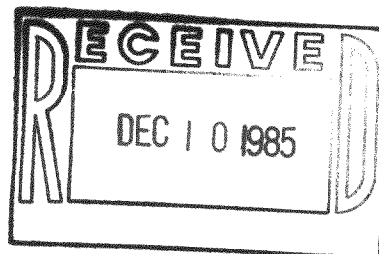

I have surveyed the above described property and the map herein is a true representation of the same and shows the size and location of the property, its exterior boundaries, the location of dimensions and of all visible structures thereon, and of adjacent lots, streets and roadways and of all other encumbrances thereon.

This survey is made for the exclusive use of the present owner of the property, and also those who purchase the same or guarantee the title thereto within one year from date hereof.

Dated at Burlington, this 23rd day of SEPTEMBER, 1985.
John F. Degen
John F. Degen, Land Surveyor # 242

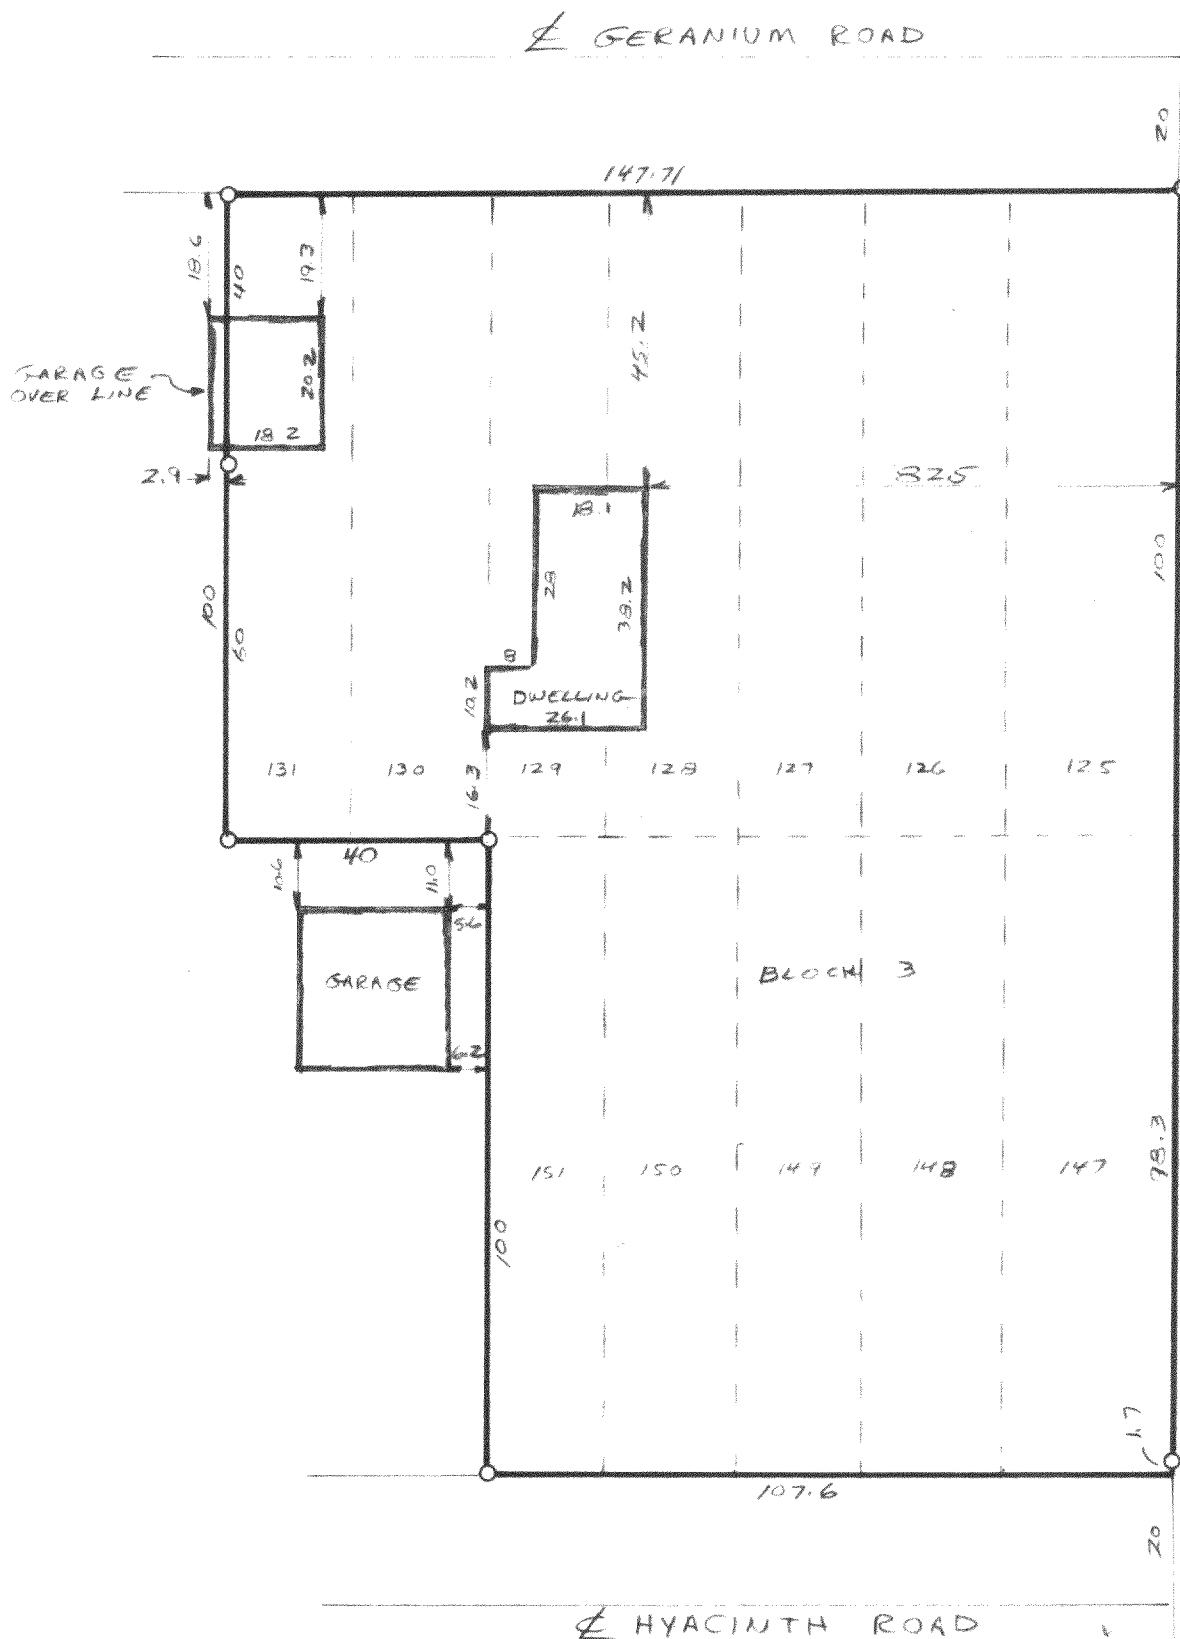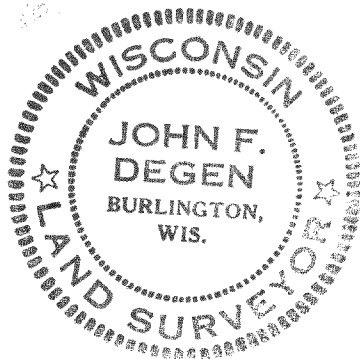

118-679D