

KOLB LAND CONSULTING, INC.
LAND SURVEYING • SUBDIVIDING • LAND PLANNING


429 WILLIAMS STREET LAKE GENEVA, WISCONSIN 53147 414-248-3697



SCALE: 1" = 40'

LEGEND

Ø IRON PIPE FOUND

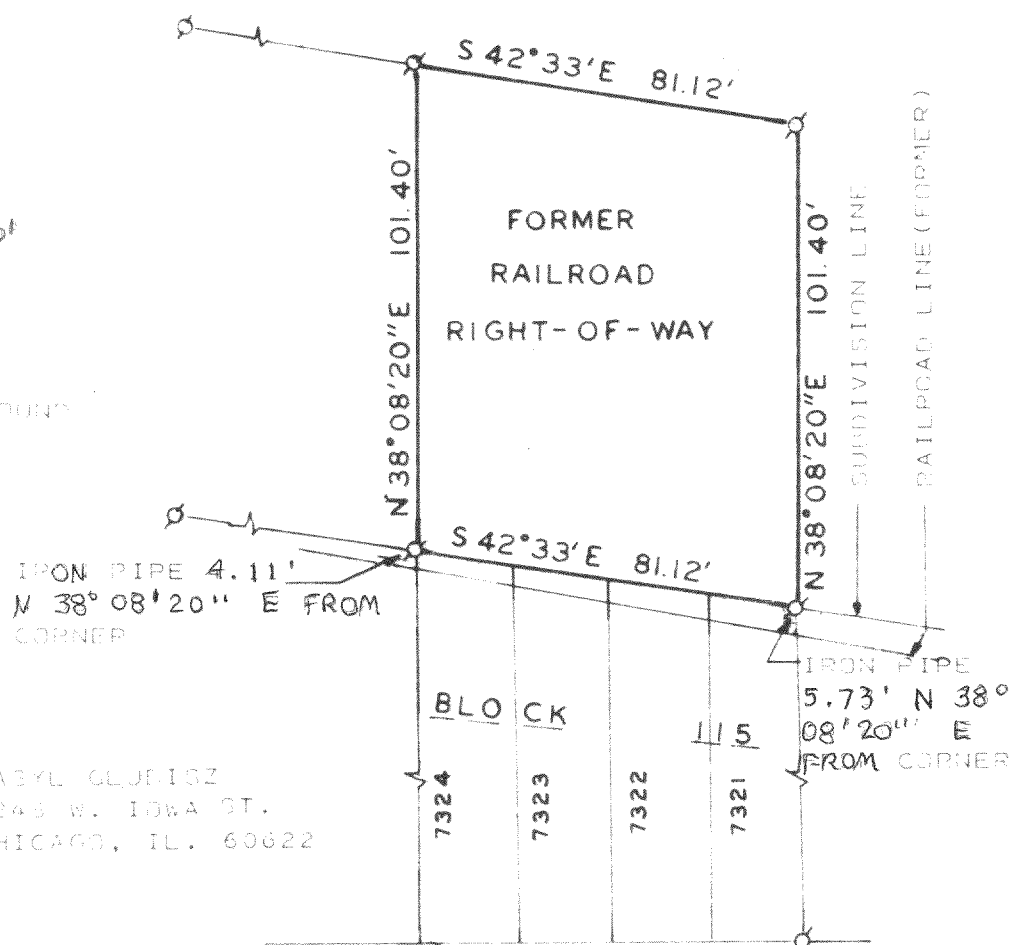

ORDERED BY: VASYL CLUEISZ
2249 W. IOWA ST.
CHICAGO, IL. 60622

NOTE: BEARINGS ASSUMED AS
SHOWN ON THE SUBDIVISION
PLAT OF PELL LAKE.

MAPLE ROAD 40' WIDE

PLAT OF SURVEY OF

PART OF THE NORTH 1/2, OF THE NORTHEAST 1/4 OF SECTION 21,
T1N, R13E, TOWN OF BLOOMFIELD, WALWORTH COUNTY, WISCONSIN.

I, HAROLD H. KOLB, DO HEREBY CERTIFY THAT
I HAVE SURVEYED THE PROPERTY HEREON DES-
CRIBED ACCORDING TO THE OFFICIAL RECORDS,
AND THAT THE PLAT HEREON IS A CORRECT REP-
RESENTATION OF THE LOT LINES TO THE BEST
OF MY KNOWLEDGE AND BELIEF.

HAROLD H. KOLB

WISCONSIN REGISTERED LAND SURVEYOR, S-137

DATE NOVEMBER 20, 1985

REVISED

REVISED

MPL-01559

118-685