


WALWORTH COUNTY
SURVEYING & MAPPING
LAKE GENEVA, WISCONSIN
SPRUCE ROAD




NOTE: SURVEY BY HAROLD H. KOLB DATED
JUNE 14, 1979 SHOWED IRON PIPE AT THIS
POINT.

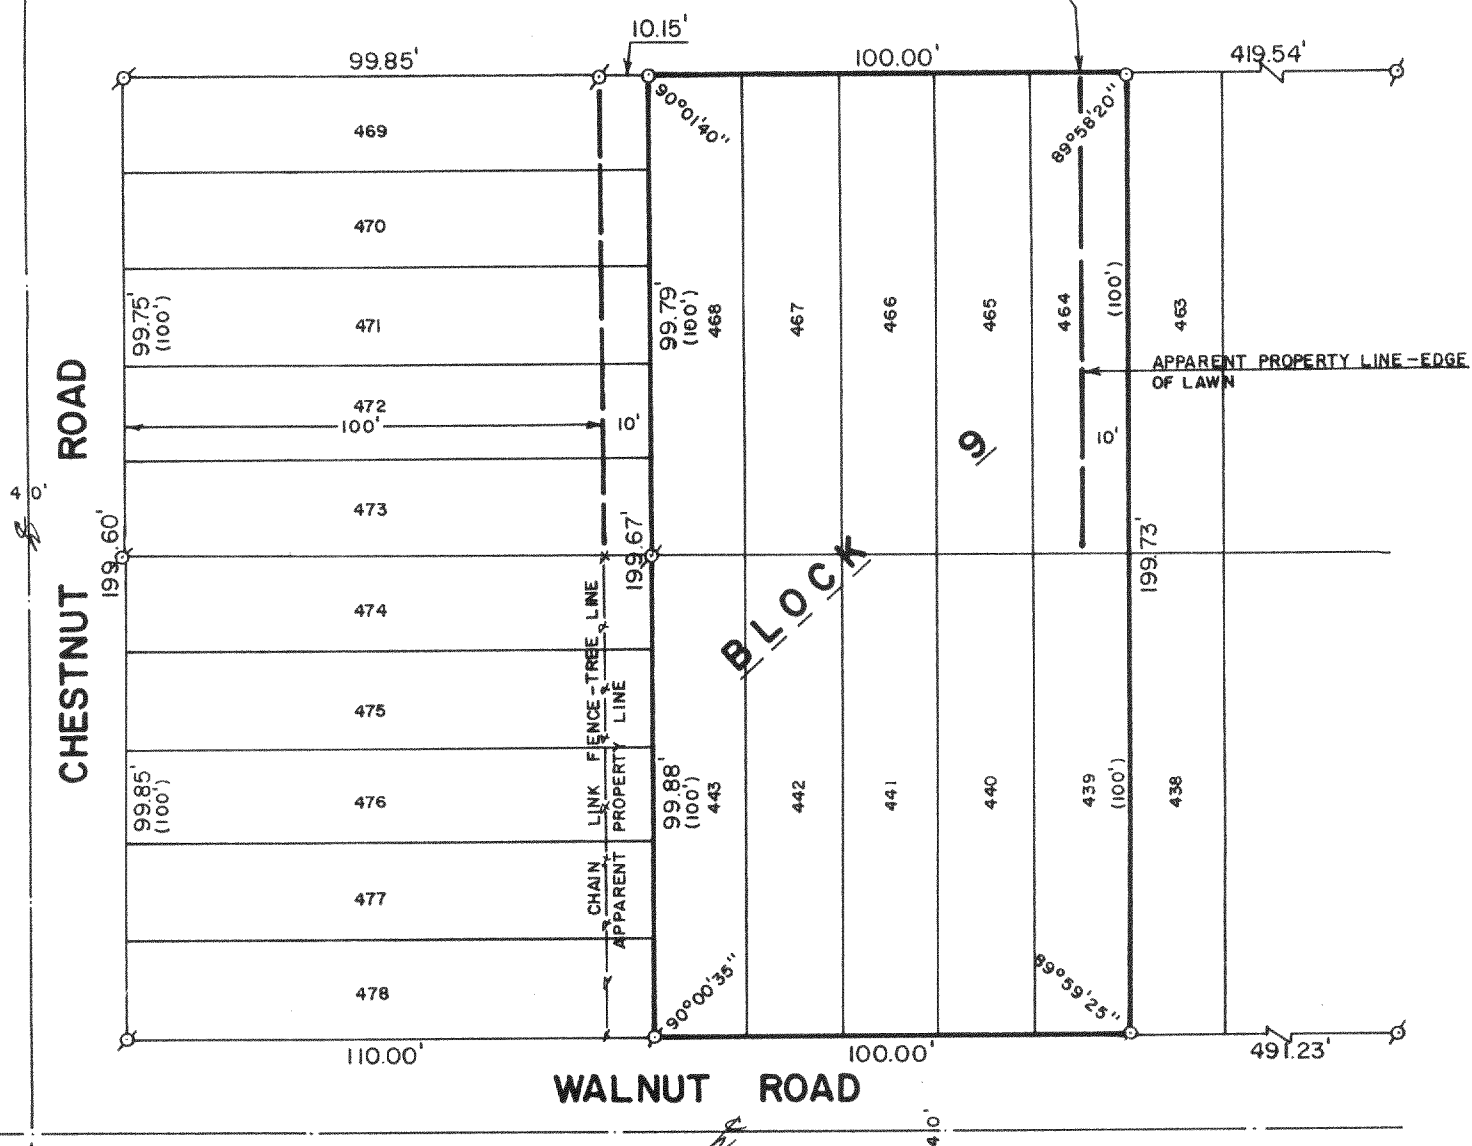

PLAT OF SURVEY OF

LOTS 439-443 AND 464-468, BLOCK 9 OF
SECTION 1 OF PELL LAKE SUBDIVISION, T 1 N,
R 18 E, WALWORTH COUNTY, WISCONSIN.

ORDERED BY: EUGENE TUMASZ
3301 NORTH DRAVE
CHICAGO, ILLINOIS 60618

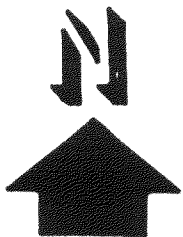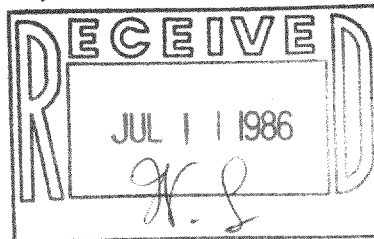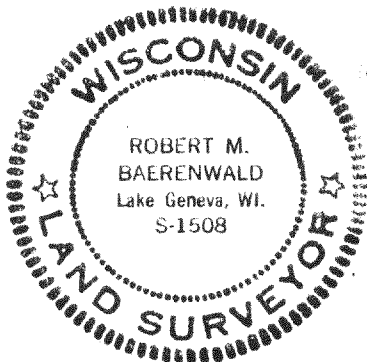

SCALE: 1"=40'

⊙ - IRON PIPE FOUND
○ - IRON ROD SET
() - RECORDED AS

I, ROBERT M. BAERENWALD, DO HEREBY CERTIFY THAT I
HAVE SURVEYED THE PROPERTY HEREON DESCRIBED ACCORDING
TO THE OFFICIAL RECORDS AND THAT THE PLAT HEREON IS A
CORRECT REPRESENTATION OF THE PROPERTY LINES TO THE
BEST OF MY KNOWLEDGE AND BELIEF.

Robert M. Baerenwald
ROBERT M. BAERENWALD
WISCONSIN REGISTERED LAND SURVEYOR, S-1508

May 28, 1986
DATE JOB NO. 0529

118-00096

118-685-13