

PLAT OF SURVEY

THE NORTH 25 FEET OF THE SOUTH 75 FEET OF LOT 25 WM. ELLIOTT'S POWERS LAKE SUBDIVISION (AS MEASURED ALONG WEST LINE OF LOT 25), AS SAME IS DESCRIBED IN VOLUME 185 PAGE 641 AND VOLUME 163 ON PAGE 272. SAID LAND LOCATED IN THE NORTHEAST FRACTIONAL 1/4 OF SECTION 13, T. 1 N., R. 18 E. OF THE 4th P.M., TOWNSHIP OF BLOOMFIELD, COUNTY OF WALWORTH, STATE OF WISCONSIN.

FOR: JAMES G. WENSHUTONIS



SCALE 1" = 10'

BEARINGS RELATE TO WEST LINE OF LOT 25 WHICH WAS USED AS PLATTED AS S. 32°36' W.

o = DENOTES IRON PIPE STAKE SET.

■ = CONCRETE MONUMENT FOUND.

--- DENOTES FENCE LINE.

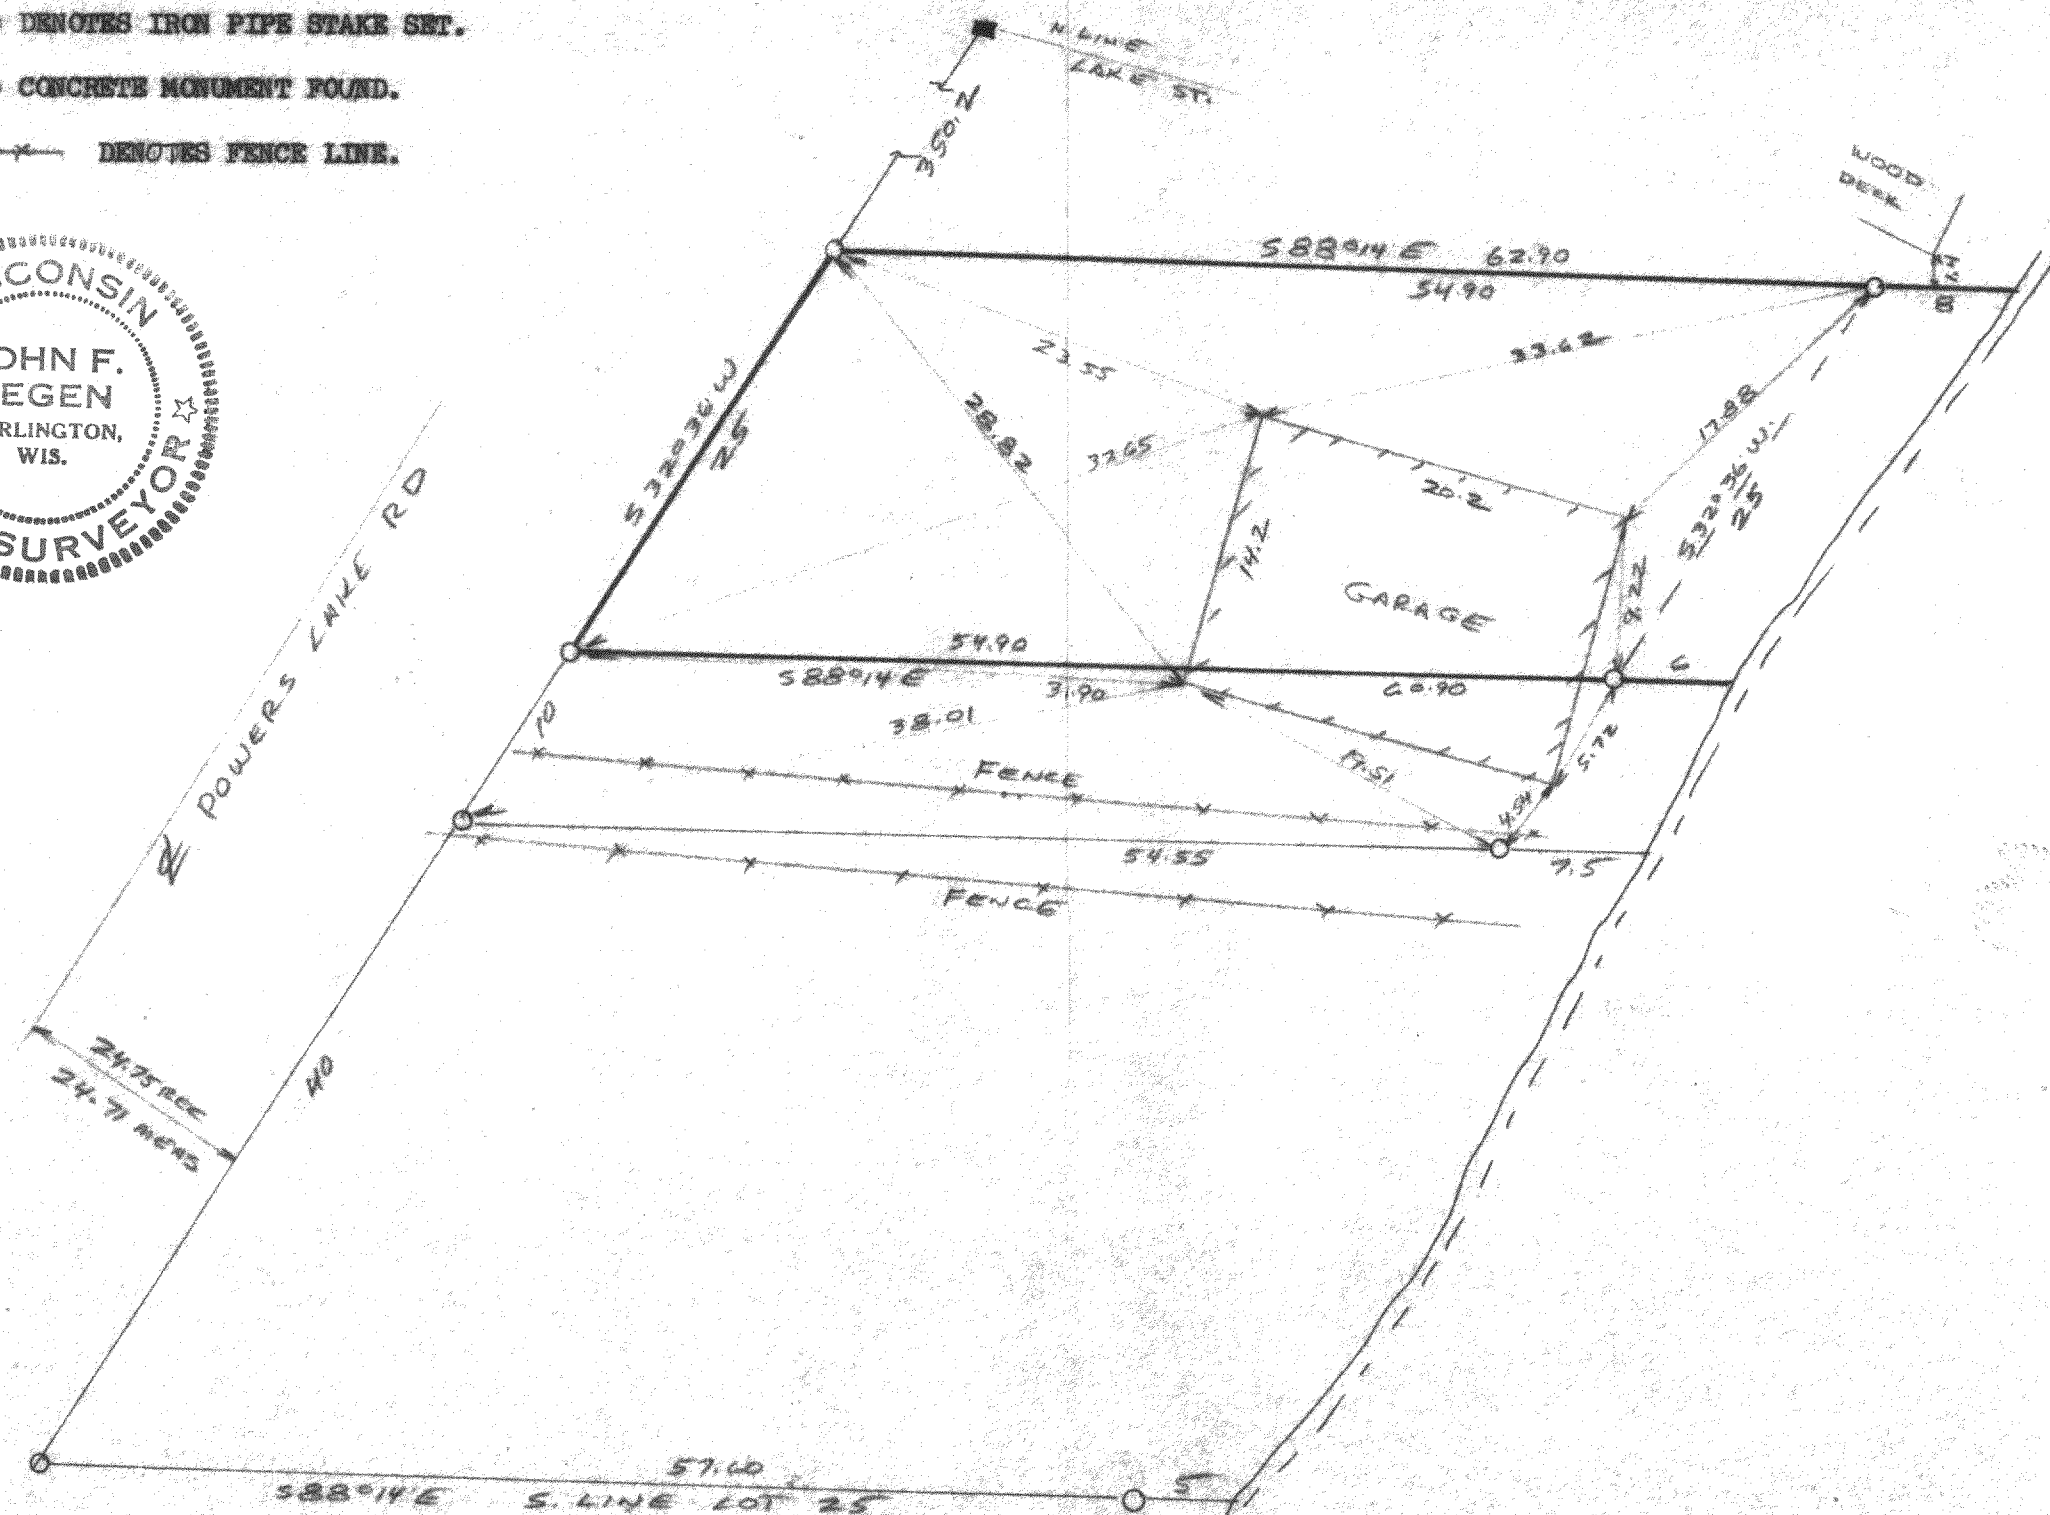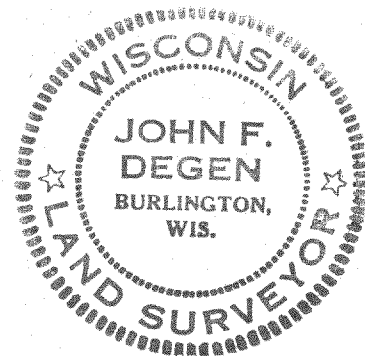

I have surveyed the above-described property and the map hereon is a true representation thereof and shows the size and location of the property, its exterior boundaries, the location and dimensions of all visible structures thereon, fences, apparent easements and roadways and visible encroachments, if any.

This survey is made for the exclusive use of the present owners of the property, and also those who purchase, mortgage, or guarantee the title thereto, within one year from date hereof.

Dated at Burlington, this 5th day of SEPT 1986
John F. Degen
 John F. Degen, Land Surveyor S 282

