

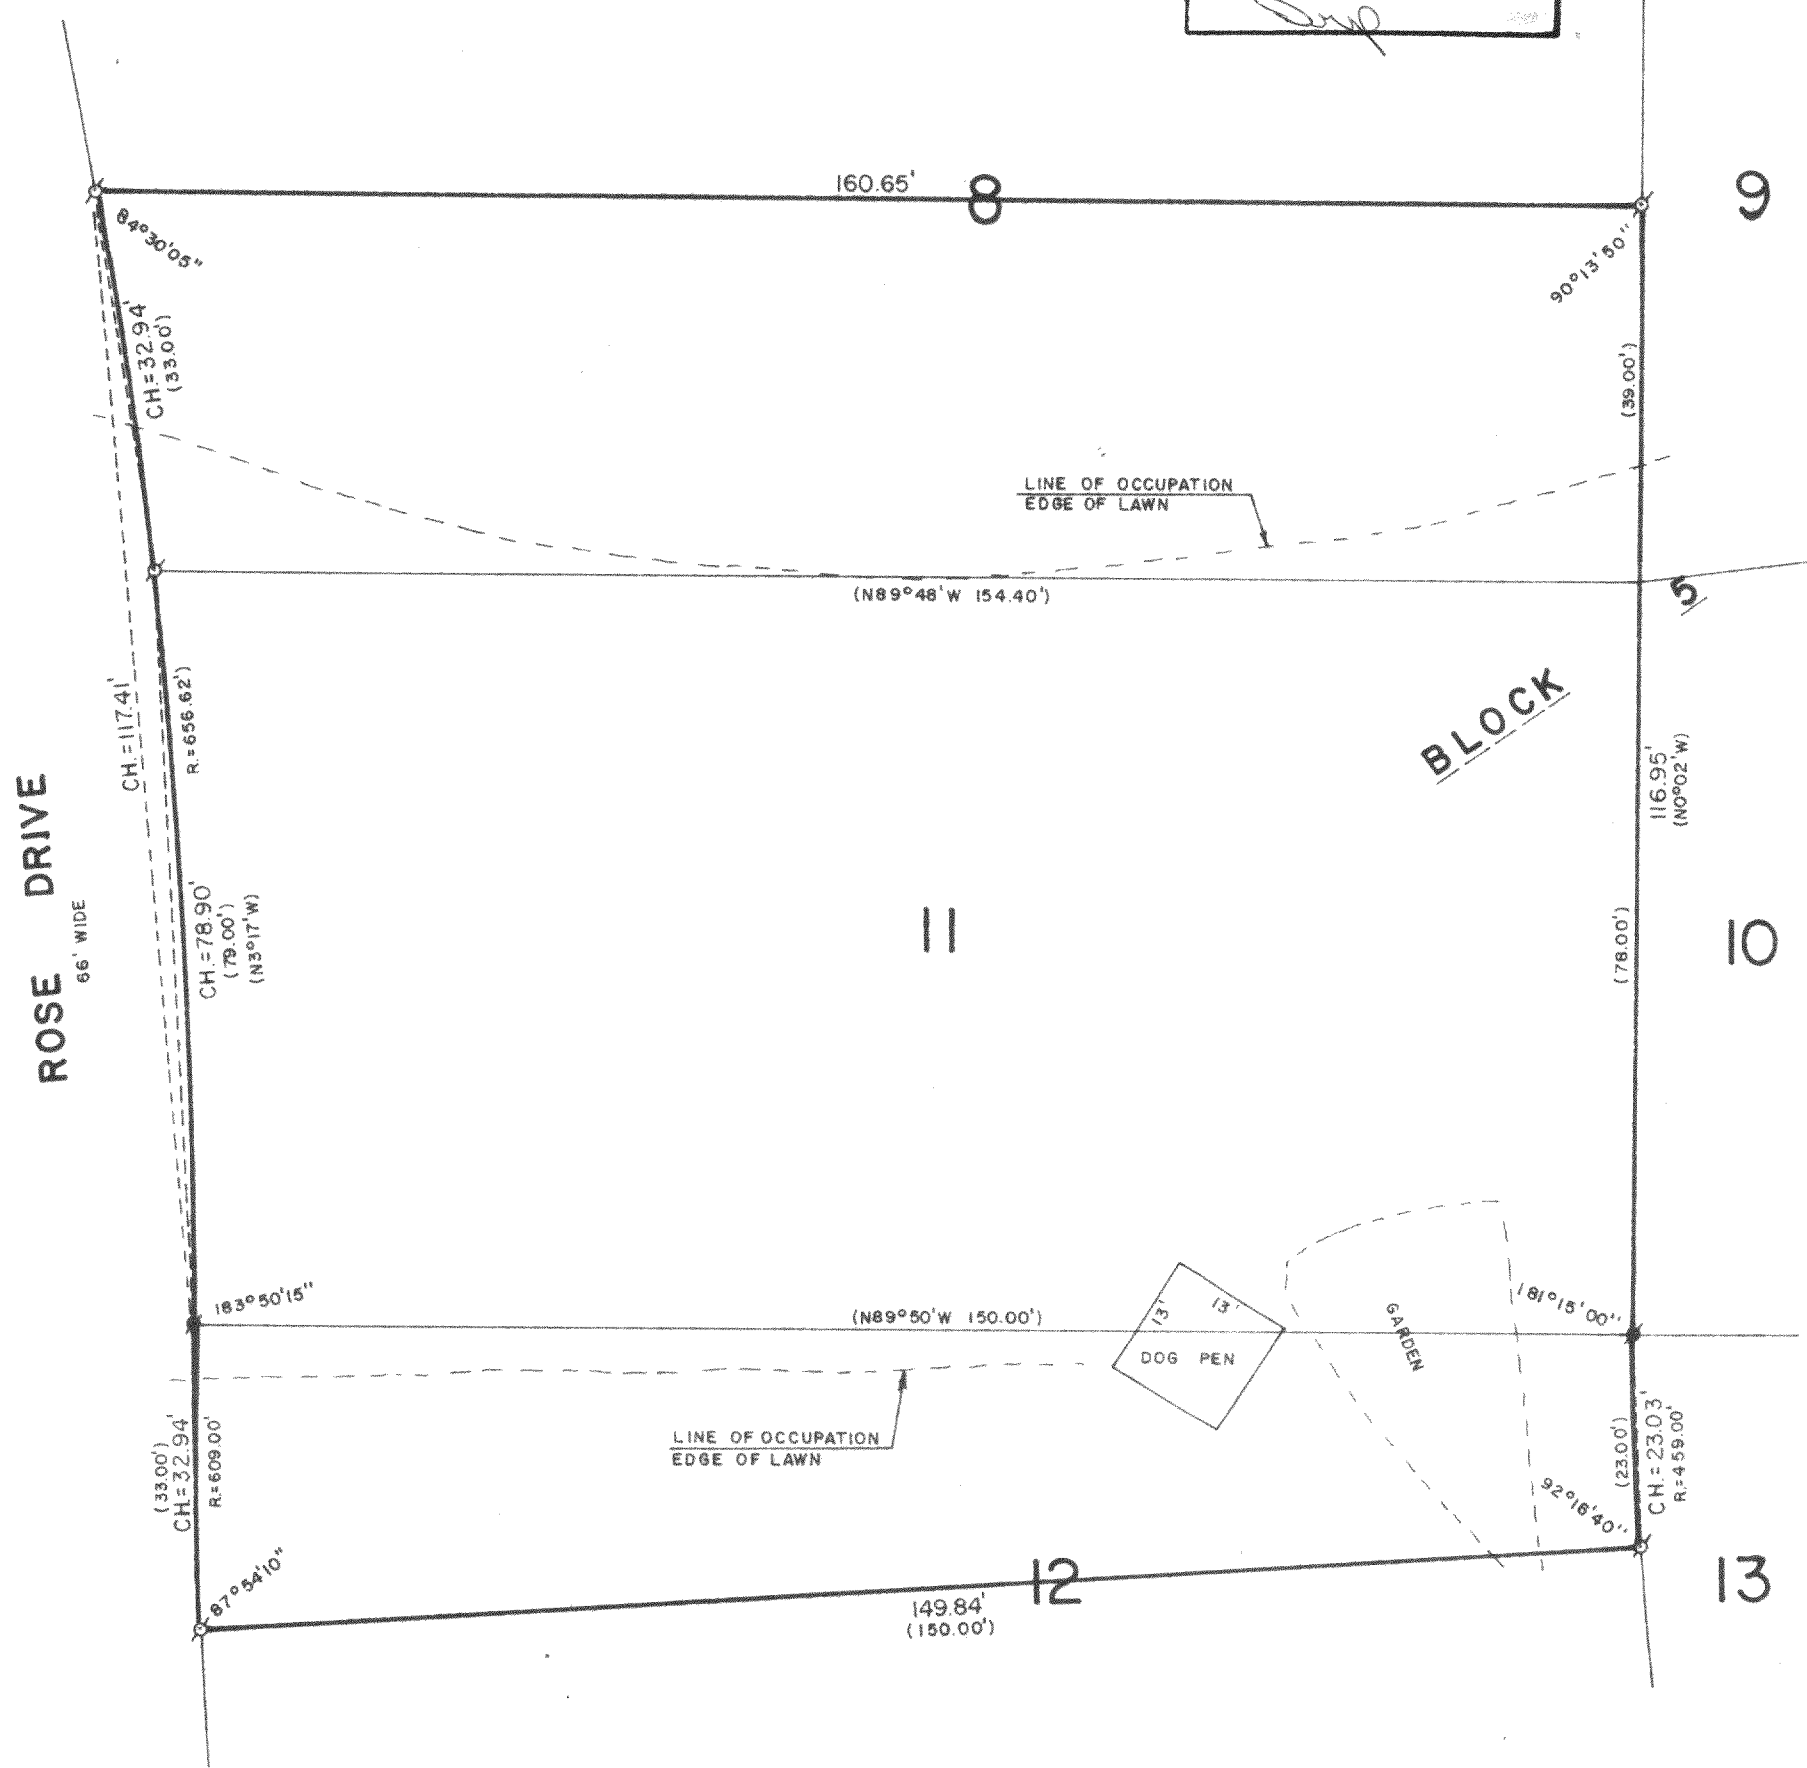


WALWORTH COUNTY
SURVEYING & MAPPING
LAKE GENEVA, WISCONSIN

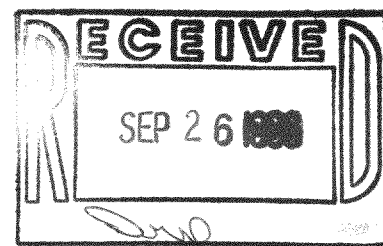

PLAT OF SURVEY OF
THE SOUTH 39 FEET OF LOT 8, ALL OF LOT 11 AND
PART OF LOT 12, BLOCK 5 OF ROSE NIPPERSTINK
GARDENS, A SUBDIVISION LOCATED IN SECTION 24,
T 1 N, R 18 E, WALWORTH COUNTY, WISCONSIN.

ORDERED BY: ALLEN LEVAIL
126 WEST RANDOLPH
CHICAGO, ILLINOIS 60601

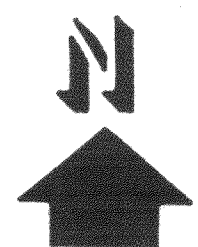

SCALE: 1"=20'

- ⊙ - IRON PIPE FOUND
- - CONCRETE MONUMENT FOUND
- () - RECORDED AS

I, ROBERT M. BAERENWALD, DO HEREBY CERTIFY THAT I
HAVE SURVEYED THE PROPERTY HEREON DESCRIBED ACCORDING
TO THE OFFICIAL RECORDS AND THAT THE PLAT HEREON IS A
CORRECT REPRESENTATION OF THE PROPERTY LINES TO THE
BEST OF MY KNOWLEDGE AND BELIEF.

Robert M. Baerenwald
ROBERT M. BAERENWALD
WISCONSIN REGISTERED LAND SURVEYOR, S-1508

DATE *Sept. 22, 1986* JOB NO. 0710

NOTE: THIS IS NOT A CERTIFIED COPY UNLESS SEALED.

MRNG-43.45

118-697