

PLAT OF SURVEY
OF


LOT 38, NIPPERINK HIGHLANDS, A SUBDIVISION LOCATED IN THE NE 1/4 OF THE NE 1/4 AND IN THE NW 1/4 OF THE NE 1/4 OF SECTION 24, BEING IN GOVERNMENT LOT 1 OF SECTION 24, TOWN 1 NORTH, RANGE 18 EAST, TOWN OF BLOOMFIELD, WALNORTH COUNTY, WISCONSIN.

FOR: ANTHONY KEYNER

BEARING DATUM IS THAT OF RECORDED PLAT.

SCALE 1" = 20'



o = IRON PIPE STAKE FOUND.

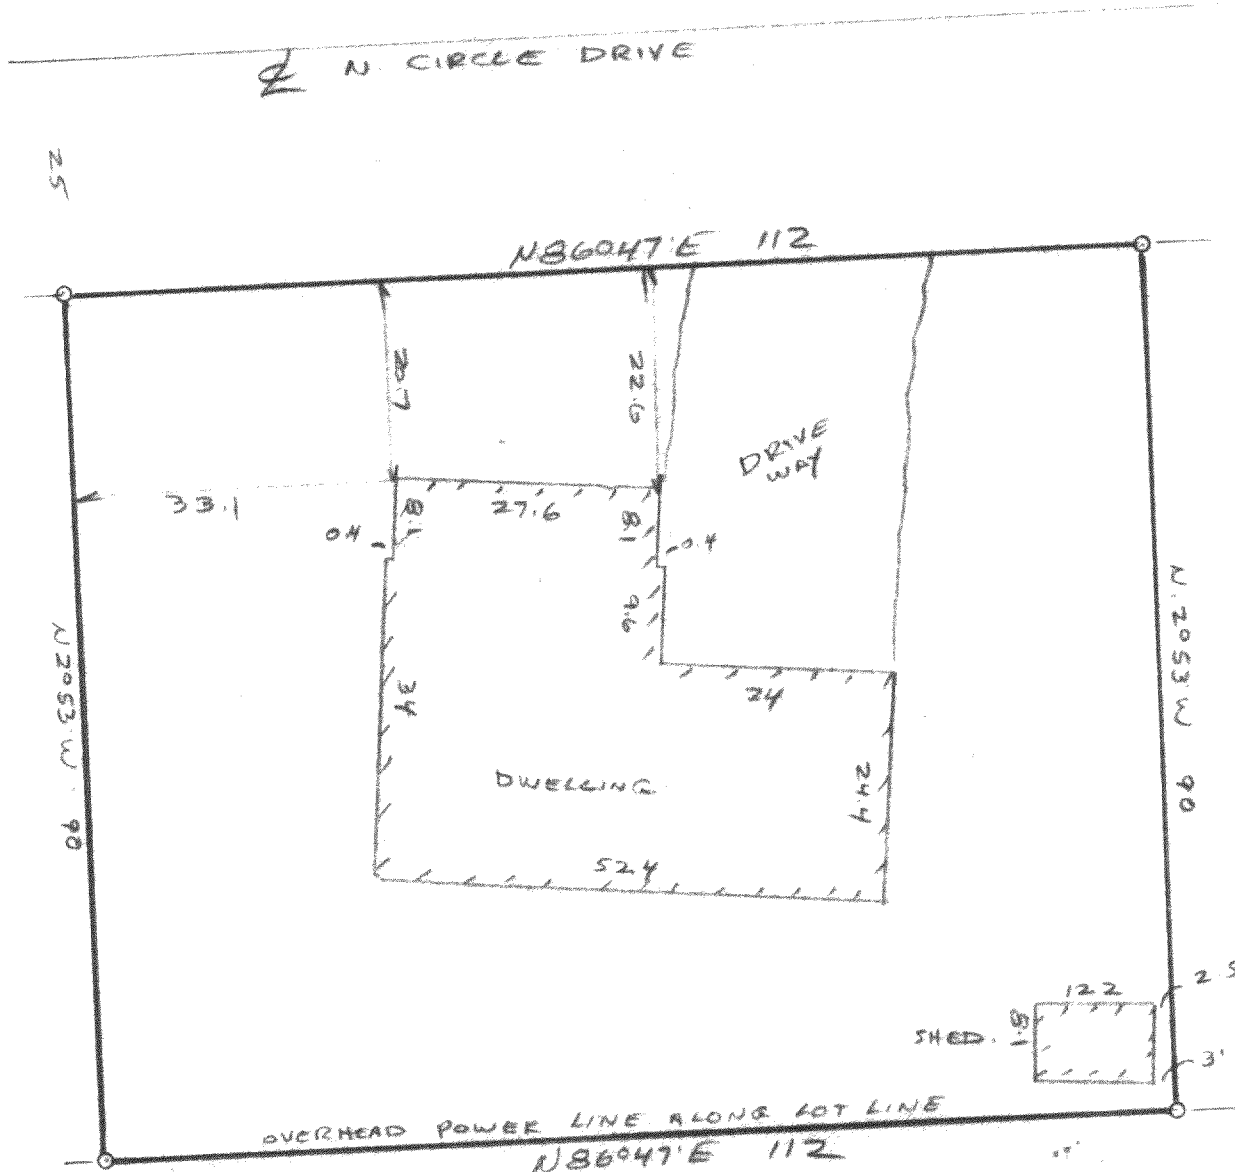

I have surveyed the above-described property, and the map hereon is a true representation thereof and shows the size and location of the property, its exterior boundaries, the location and dimensions of all visible structures thereon, fences, apparent easements and roadways and visible encroachments, if any.

This survey is made for the exclusive use of the present owners of the property, and also those who purchase, mortgage, or guarantee the title thereto, within one year from date hereof.

Dated at Burlington, this 9th day of SEPT, 1986
John F. Degen
John F. Degen, Land Surveyor S 242

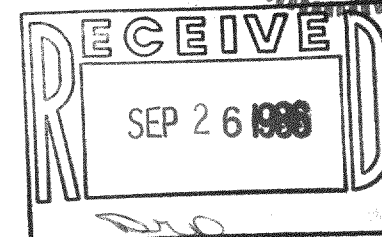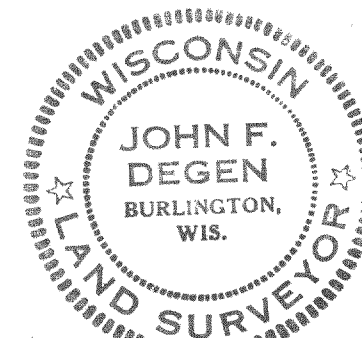

11-C-1 #28

MNH-38

110-690