


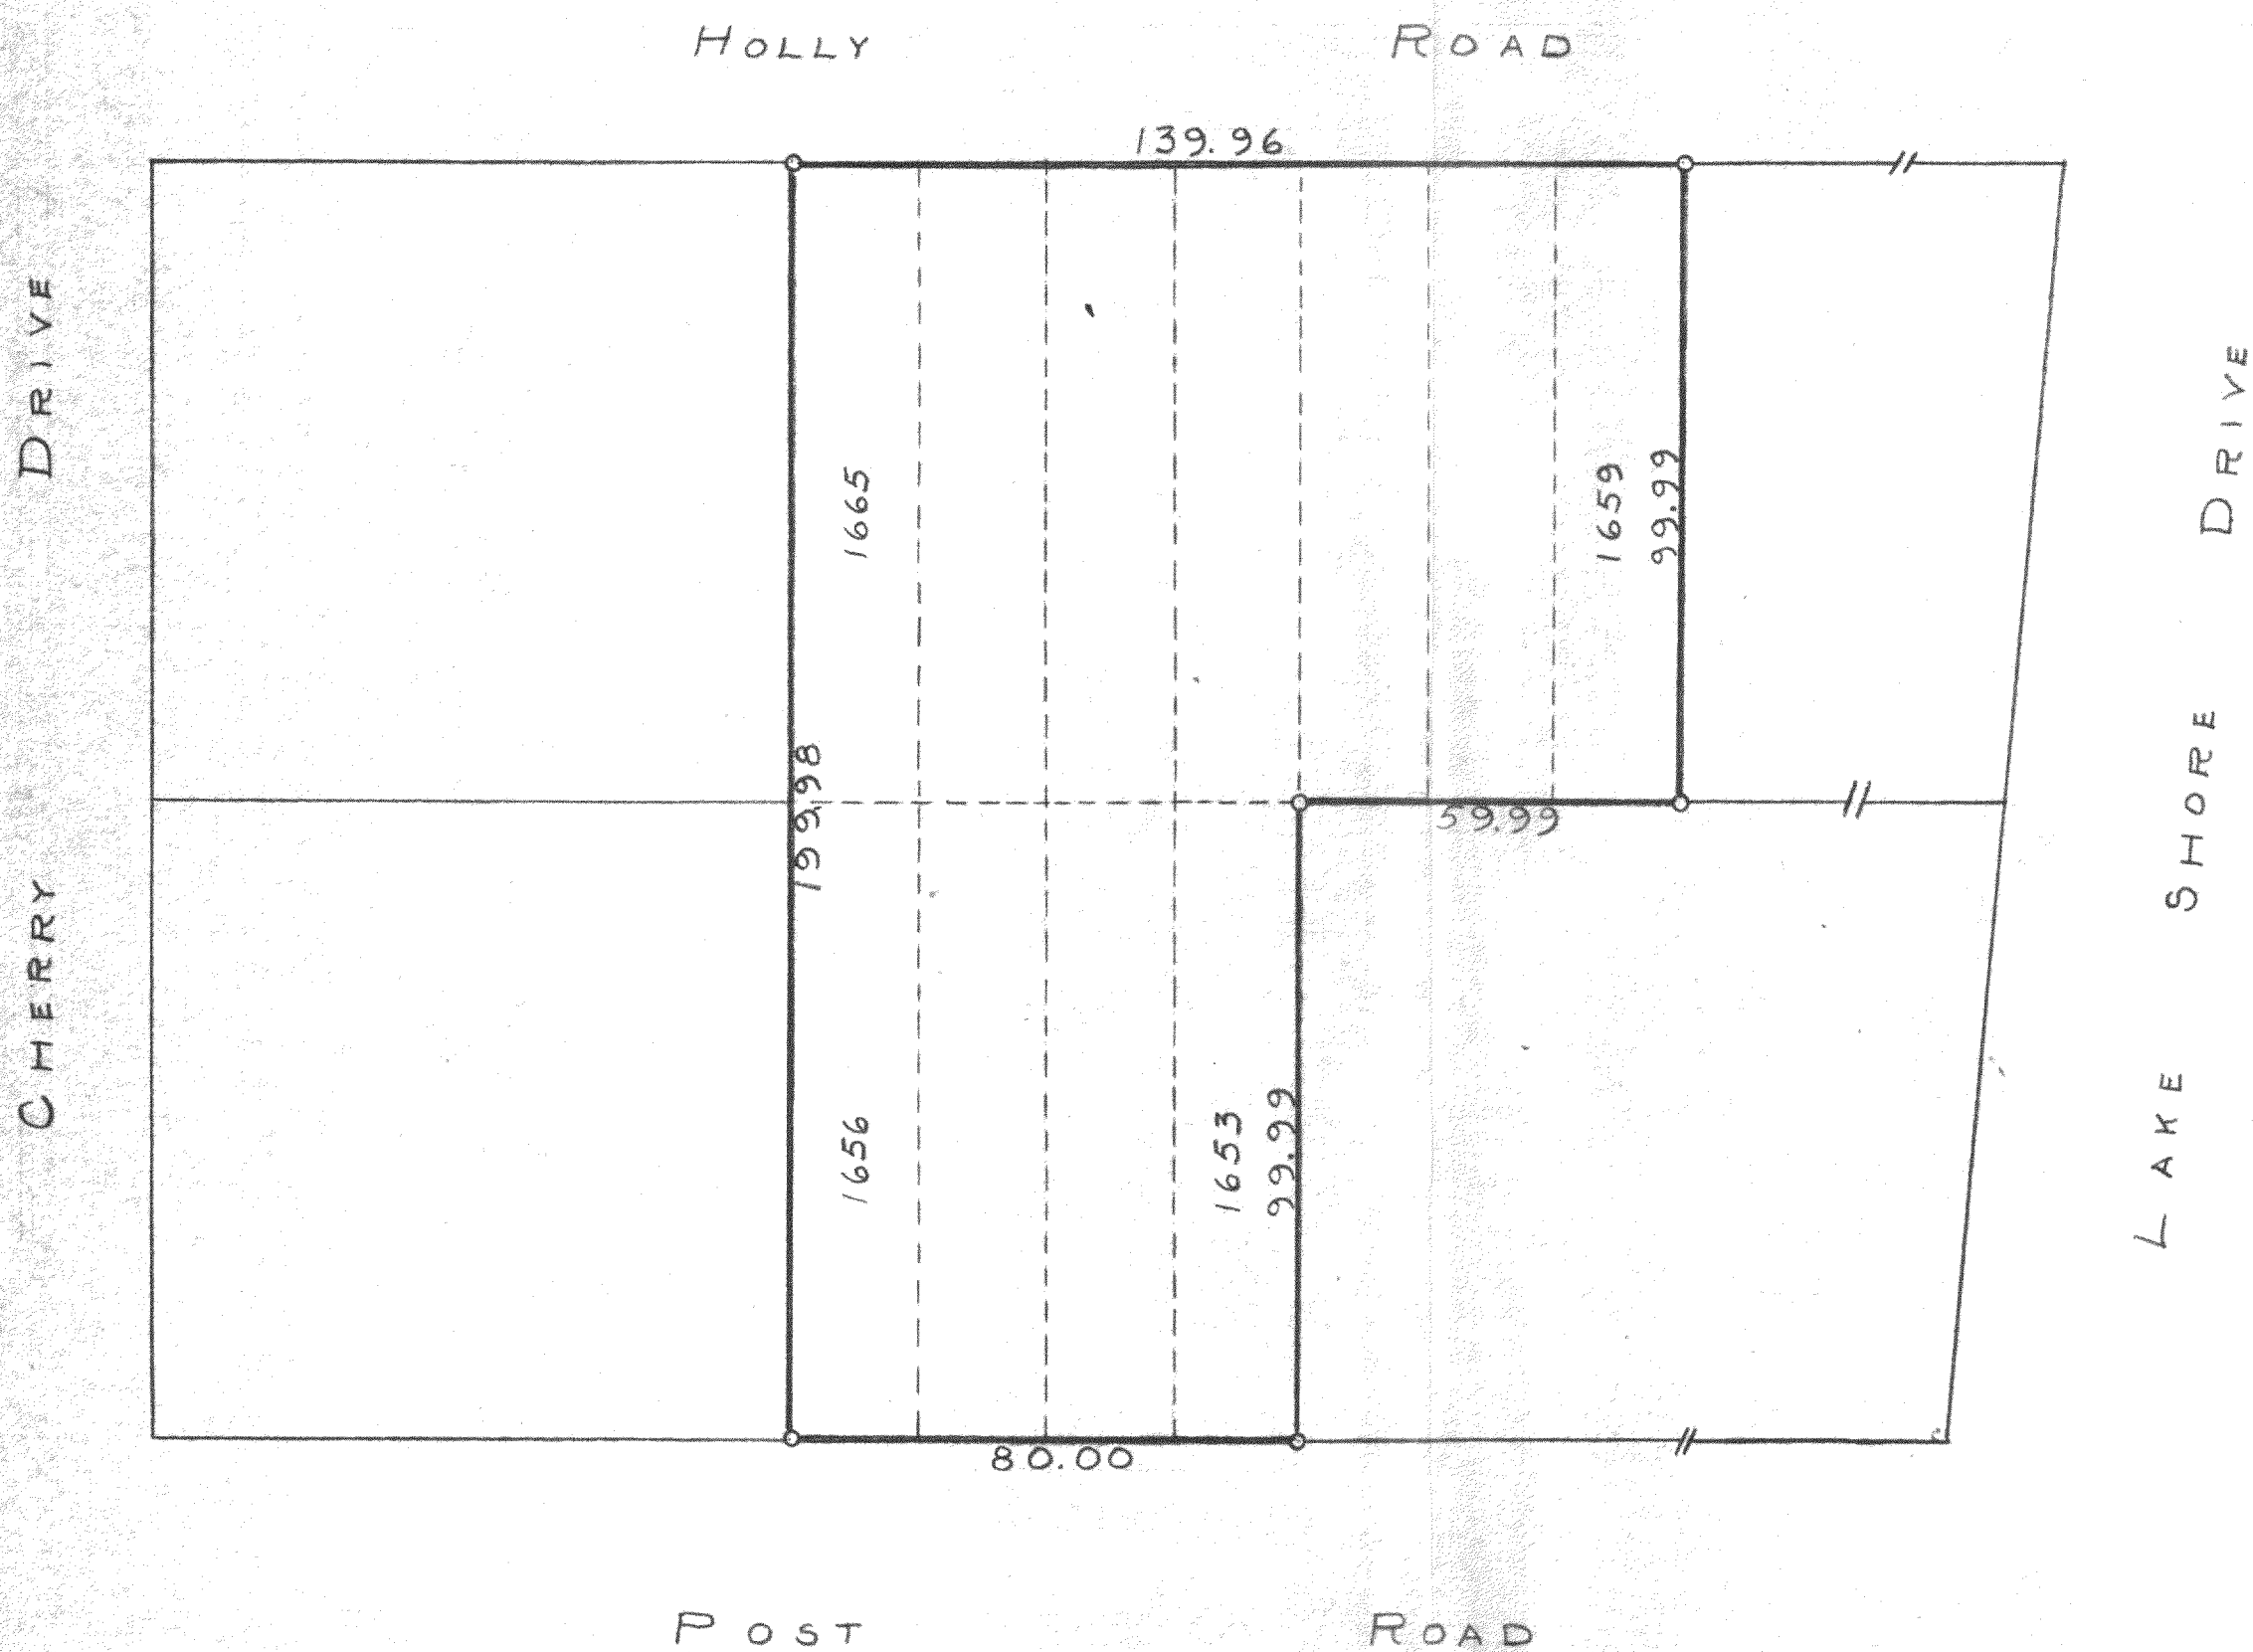

PLAT OF SURVEY OF LOTS 1653-1656 INCLUSIVE AND 1659-1665
 INCLUSIVE PELL LAKES. SECTION 1, LOCATED IN SECTION 22,
 T1N R18E OF WALWORTH COUNTY, WISCONSIN
 OCT. 13, 1954

George T. Dunham
 GEORGE T. DUNHAM, SURVEYOR
 DELAVAN, WISCONSIN

118-7