


PLAT OF SURVEY OF

Part of Lot 14 in Wm. Elliott's Power's Lake Subdivision located in the NE 1/4 of Section 13, Town 1 North, Range 18 East, Walworth County, Wisconsin, described as follows, to-wit: Beginning at the SW corner of said Lot 14; thence Southeasterly along the Southerly line of said Lot 121.60 feet, which point is the NW corner of Lot 17; thence North 29°50' East 6 feet to a point; thence South 70°10' East 149.20 feet, more or less, to a public road; thence North 29°50' East along said road 76.82 feet, more or less, to the shore of Power's Lake; thence Northwesterly along the shore of Power's Lake 36 feet more or less to a point; thence North 76°53' West 254.27 feet to a public road; thence South 24°45' West 57.13 feet along such road to the place of beginning.

Legal Description taken from deed--Document #521529, Vol. 555, Pg. 157. Parcel listed under Tax key # E-14A at the Walworth County Courthouse.

Surveyed for: Arnold B. Kalnitz, Attorney
111 W. Washington - Suite 737
Chicago, IL. 60602

Jensen Surveying & Mapping S.C.
45 S. Wisconsin St. P.O. Box 322
Elkhorn, Wisconsin. 53121
(414) 723-3434

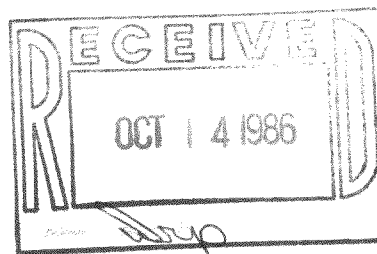


SCALE 1"=50'

LEGEND

- O ~ FOUND IRON PIPE
- X ~ FOUND SPIKE IN TREE ROOT
- () ~ RECORDED AS DIMENSION

AUGUST 26, 1986

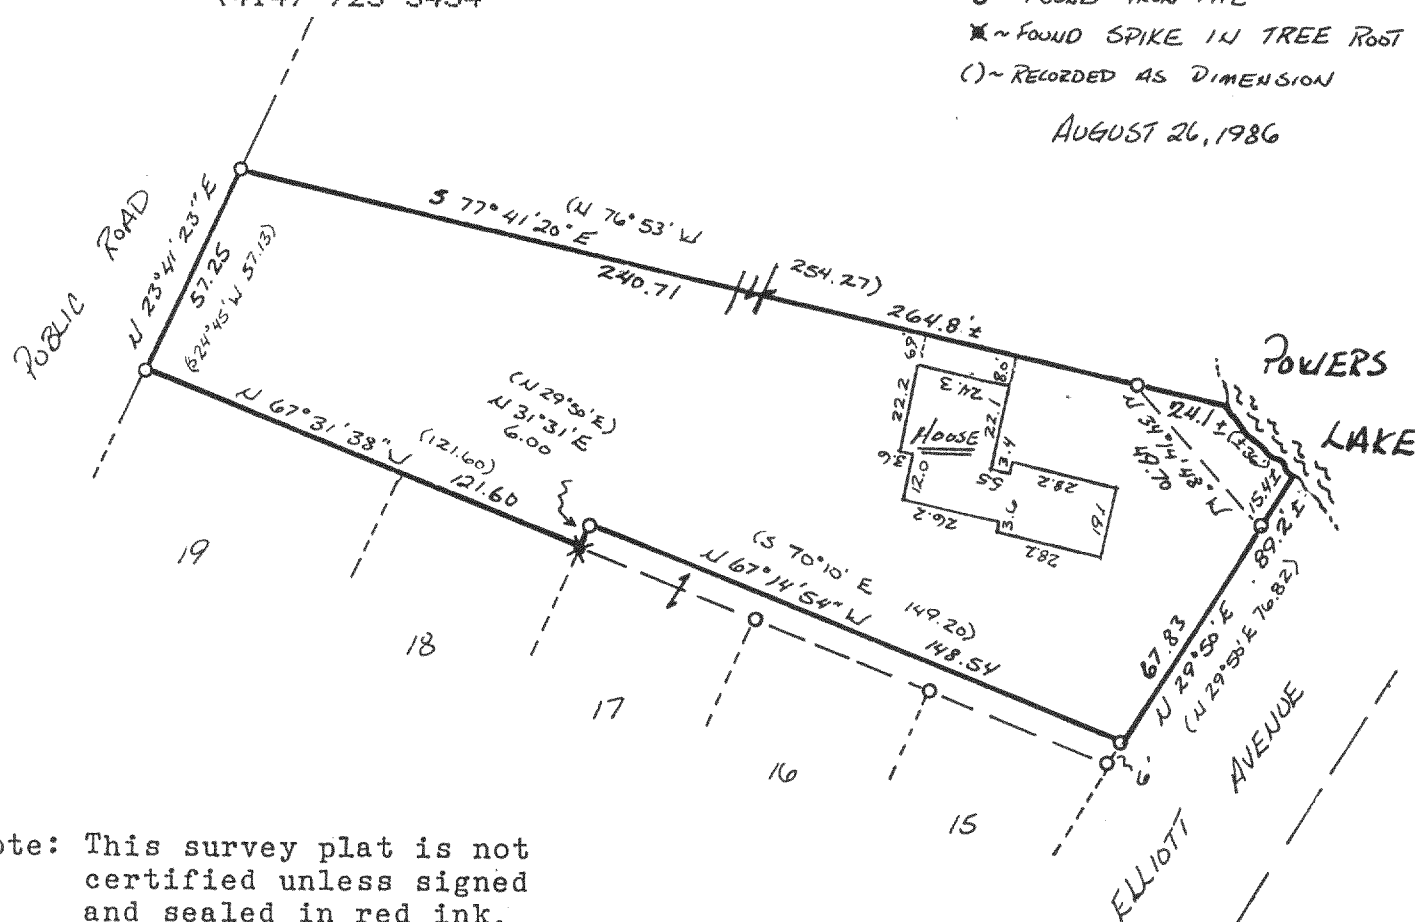

Note: This survey plat is not certified unless signed and sealed in red ink.

I, Thomas P.A. Jensen, Wisconsin Registered Land Surveyor, do hereby certify that this survey was performed by me, or under my direction, in full compliance with the owner's/agent's instructions and chapter A-E 5 of the Wisconsin Administrative Code "Minimum Standards For Property Surveys"; and that this map is an accurate representation thereof to the best of my knowledge and belief.

Thomas P.A. Jensen S-1084
Jensen Surveying & Mapping S.C.

1986.072 X

118-701