


KOLB LAND CONSULTING, INC.
LAND SURVEYING • SUBDIVIDING • LAND PLANNING

929 WILLIAMS STREET LAKE GENEVA, WISCONSIN 53147 414-248-3697

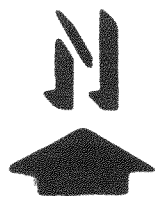

SCALE: 1" = 40'

WILD ROSE ROAD 66' WIDE

LEGEND



- IRON PIPE FOUND
- △ UTILITY POLE
- OVERHEAD UTILITY LINE
- SW SIDE WALK

NOTE: BEARINGS ARE BASED
ON LOT 1 OF CERTIFIED
SURVEY MAP NO. 540.
ASSUMED.

ORDERED BY: JANICE LEVERNIER
RT. 1 BOX 17B
GENOA CITY, WI.
53128

PLAT OF SURVEY OF

A PARCEL OF LAND LOCATED
IN THE NORTHEAST 1/4 OF
SECTION 36, T1N, R18E,
TOWN OF BLOOMFIELD, WAL
WORTH COUNTY, WISCONSIN.

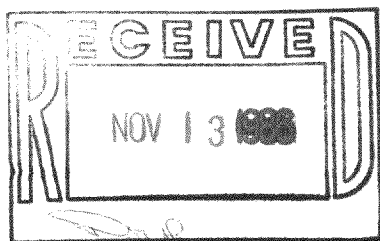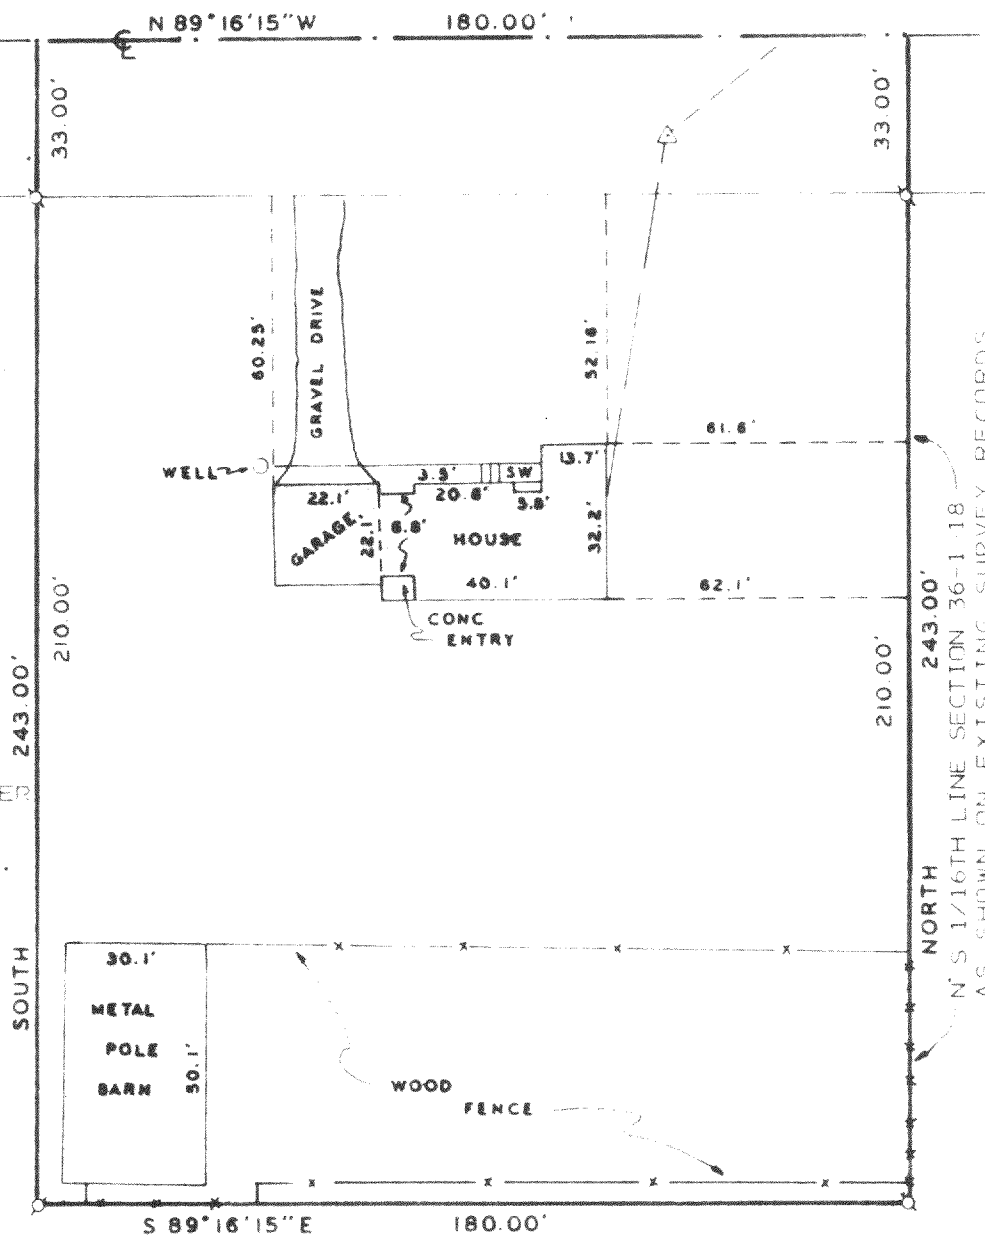

I HEREBY CERTIFY THAT I HAVE SURVEYED THE ABOVE DESCRIBED PROPERTY AND THAT THE ABOVE MAP IS A TRUE REPRESENTATION THEREOF AND SHOWS THE SIZE AND LOCATION OF THE PROPERTY, ITS EXTERIOR BOUNDARIES, THE LOCATION OF ALL VISIBLE STRUCTURES AND DIMENSIONS OF ALL PRINCIPAL BUILDINGS THEREON, BOUNDARY FENCES, APPARENT EASEMENTS, ROADWAYS AND VISIBLE ENCROACHMENTS, IF ANY, TO THE BEST OF MY KNOWLEDGE AND BELIEF. THIS SURVEY IS MADE FOR THE USE OF THE PRESENT OWNERS OF THE PROPERTY AND ALSO THOSE WHO PURCHASE, MORTGAGE, OR GUARANTEE THE TITLE THERETO WITHIN ONE (1) YEAR FROM DATE HEREOF.

Harold H. Kolb

HAROLD H. KOLB

WISCONSIN REGISTERED LAND SURVEYOR, S-187

DATE JULY 23, 1986

REVISED

REVISED

