
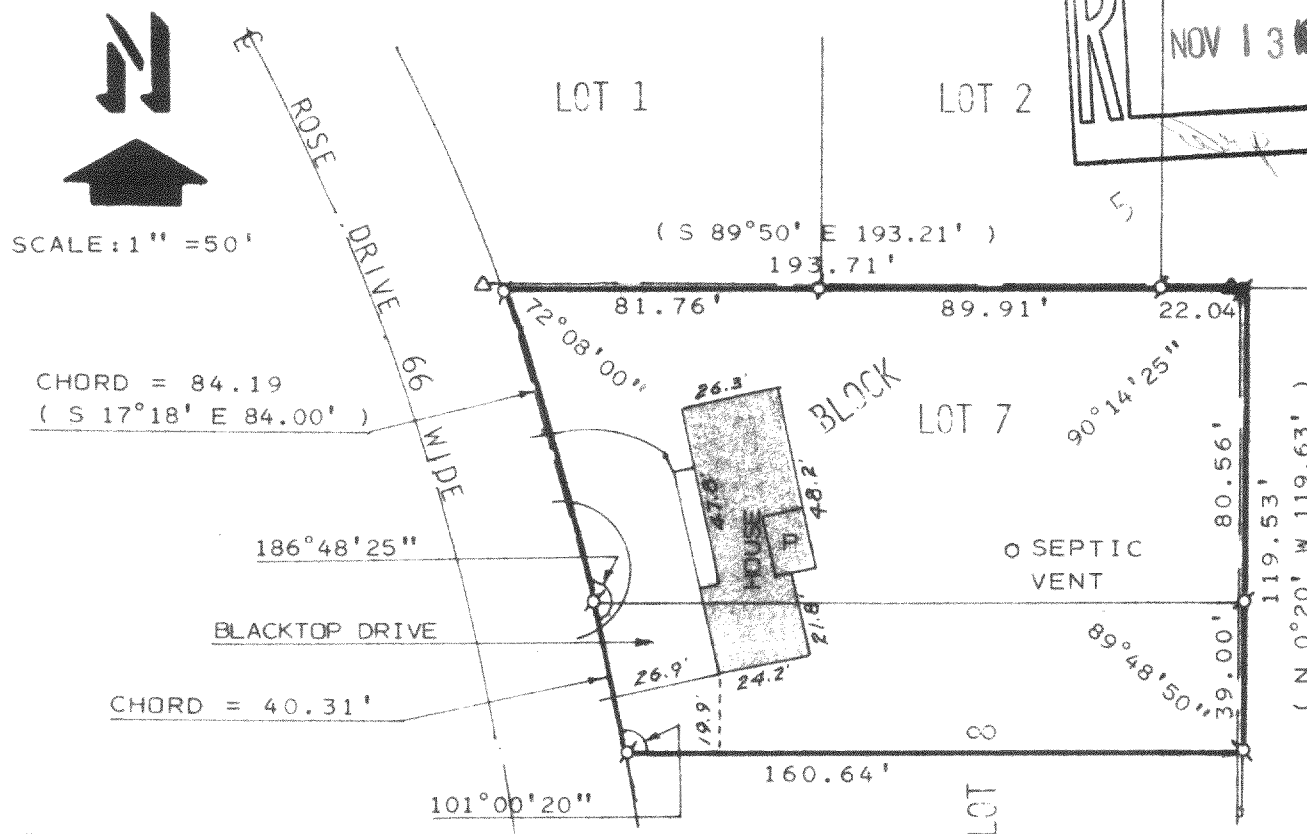


KOLB LAND CONSULTING, INC.
LAND SURVEYING • SUBDIVIDING • LAND PLANNING

929 WILLIAMS STREET LAKE GENEVA, WISCONSIN 53147 414-248-3697

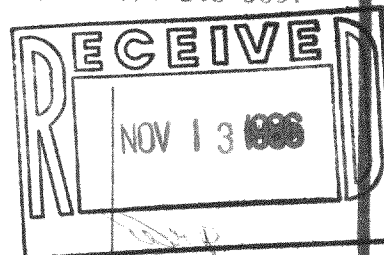

PLAT OF SURVEY OF
LOT 7 AND THE NORTH 39.00 FEET OF LOT 8, BLOCK 5, ROSE
NIPPERSINK GARDENS SUBDIVISION, LOCATED IN SECTION 24,
T 1 N, R 18 E, TOWN OF BLOOMFIELD, WALWORTH CO., WI.


LEGEND

- Ø - IRON PIPE FOUND
- - CONCRETE MONUMENT FOUND
- () - AS RECORDED
- P - PORCH
- △ - UTILITY POLE
- — — OVERHEAD UTILITY LINE

ORDERED BY: KEEFE REAL ESTATE, INC.
704 MAIN
LAKE GENEVA, WI. 53147

I HEREBY CERTIFY THAT I HAVE SURVEYED THE
ABOVE DESCRIBED PROPERTY AND THAT THE ABOVE
MAP IS A TRUE REPRESENTATION THEREOF AND
SHOWS THE SIZE AND LOCATION OF THE PROPERTY,
ITS EXTERIOR BOUNDARIES, THE LOCATION OF ALL
VISIBLE STRUCTURES AND DIMENSIONS OF ALL
PRINCIPAL BUILDINGS THEREON, BOUNDARY FENCES,
APPARENT EASEMENTS, ROADWAYS AND VISIBLE
ENCROACHMENTS, IF ANY, TO THE BEST OF MY
KNOWLEDGE AND BELIEF.

THIS SURVEY IS MADE FOR THE USE OF THE
PRESENT OWNERS OF THE PROPERTY, AND ALSO
THOSE WHO PURCHASE, MORTGAGE, OR GUARANTEE
THE TITLE THERETO WITHIN ONE (1) YEAR FROM
DATE HEREOF.

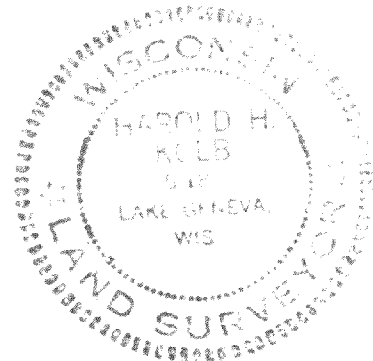

Harold H. Kolb

HAROLD H. KOLB

WISCONSIN REGISTERED LAND SURVEYOR, S-187

DATE AUGUST 8, 1986

REVISED _____

REVISED _____