

PLAT OF SURVEY  
OF

LOT 5, ZUNDE SUBDIVISION, LOCATED IN THE EAST HALF OF SECTION 13, T. 1 N., R. 18 E.  
OF THE 4TH P.M., TOWNSHIP OF BLOOMFIELD, COUNTY OF WAINWORTH, STATE OF WISCONSIN.

FOR: ZAGORSKI


SCALE 1" = 20'

BEARINGS RELATE TO NORTH LINE OF  
LOT 5 WHICH WAS USED AS PLATTED  
AS N. 77°16' W.

o = IRON PIPE STAKE SET.

o = IRON PIPE STAKE FOUND.

\*\*\* DENOTES FENCE LINE.

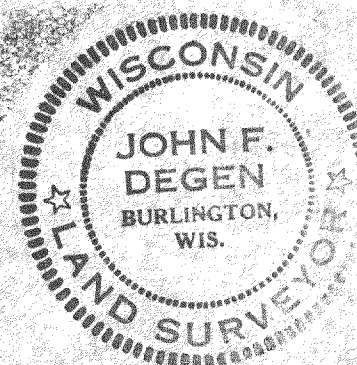


I have surveyed the above-described property  
and the map hereon is a true representation  
thereof and shows the size and location of the  
property, its exterior boundaries, the location  
and dimensions of all visible structures thereon,  
fences, apparent easements and roadways and  
visible encroachments, if any.

This survey is made for the exclusive use of  
the present owners of the property, and also  
those who purchase, mortgage, or guarantee  
the title thereto, within one year from date  
hereof.

Dated at Burlington, this 15th day  
of October, 1986

John F. Degen, Land Surveyor S 242

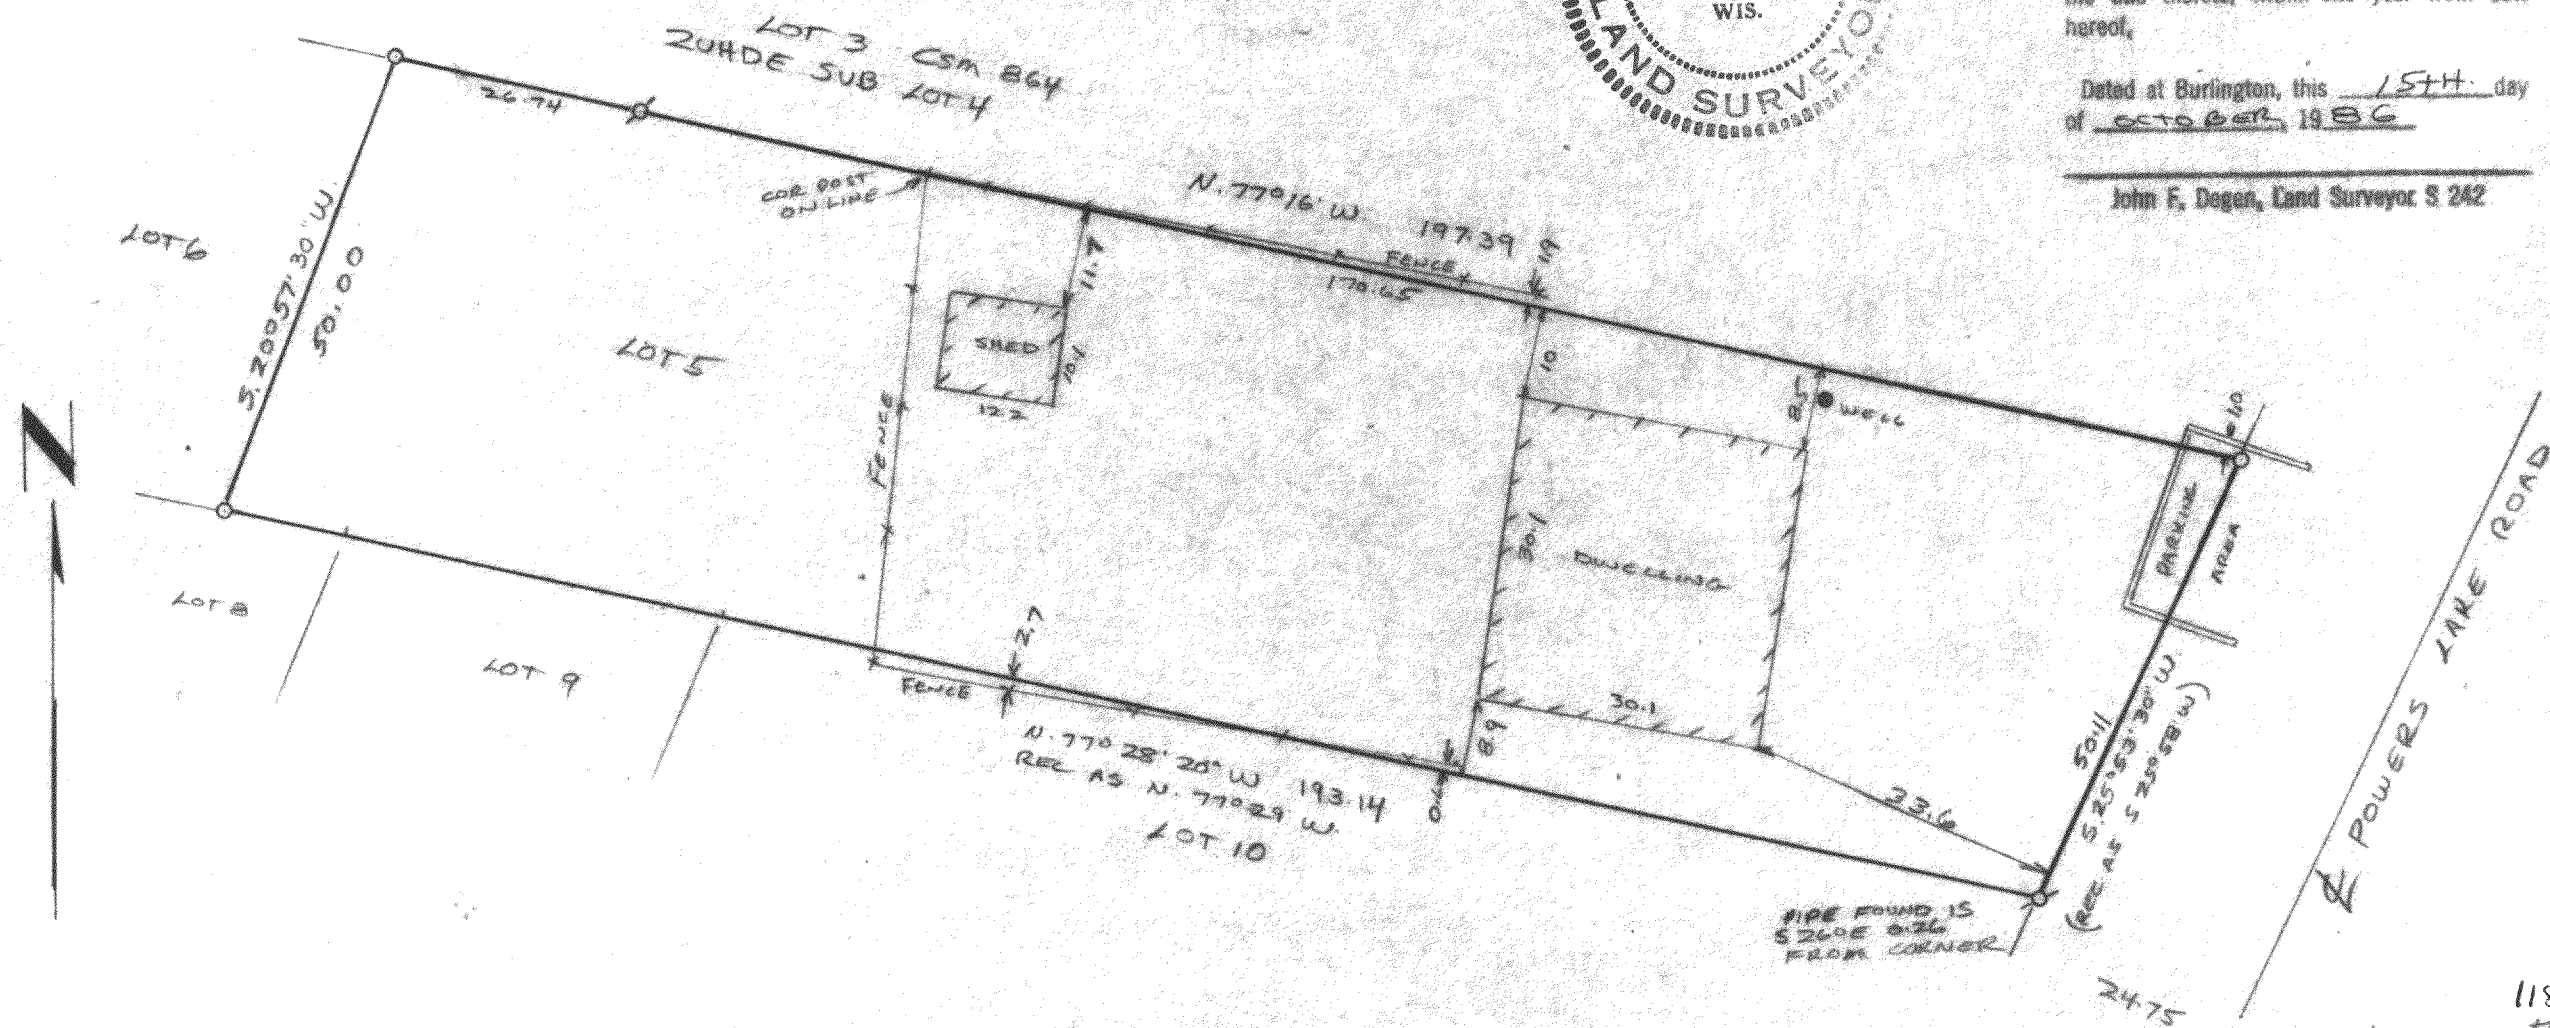

m2-6

118-718  
14-D-1 #35