


DUNBAR BOULEVARD 40'

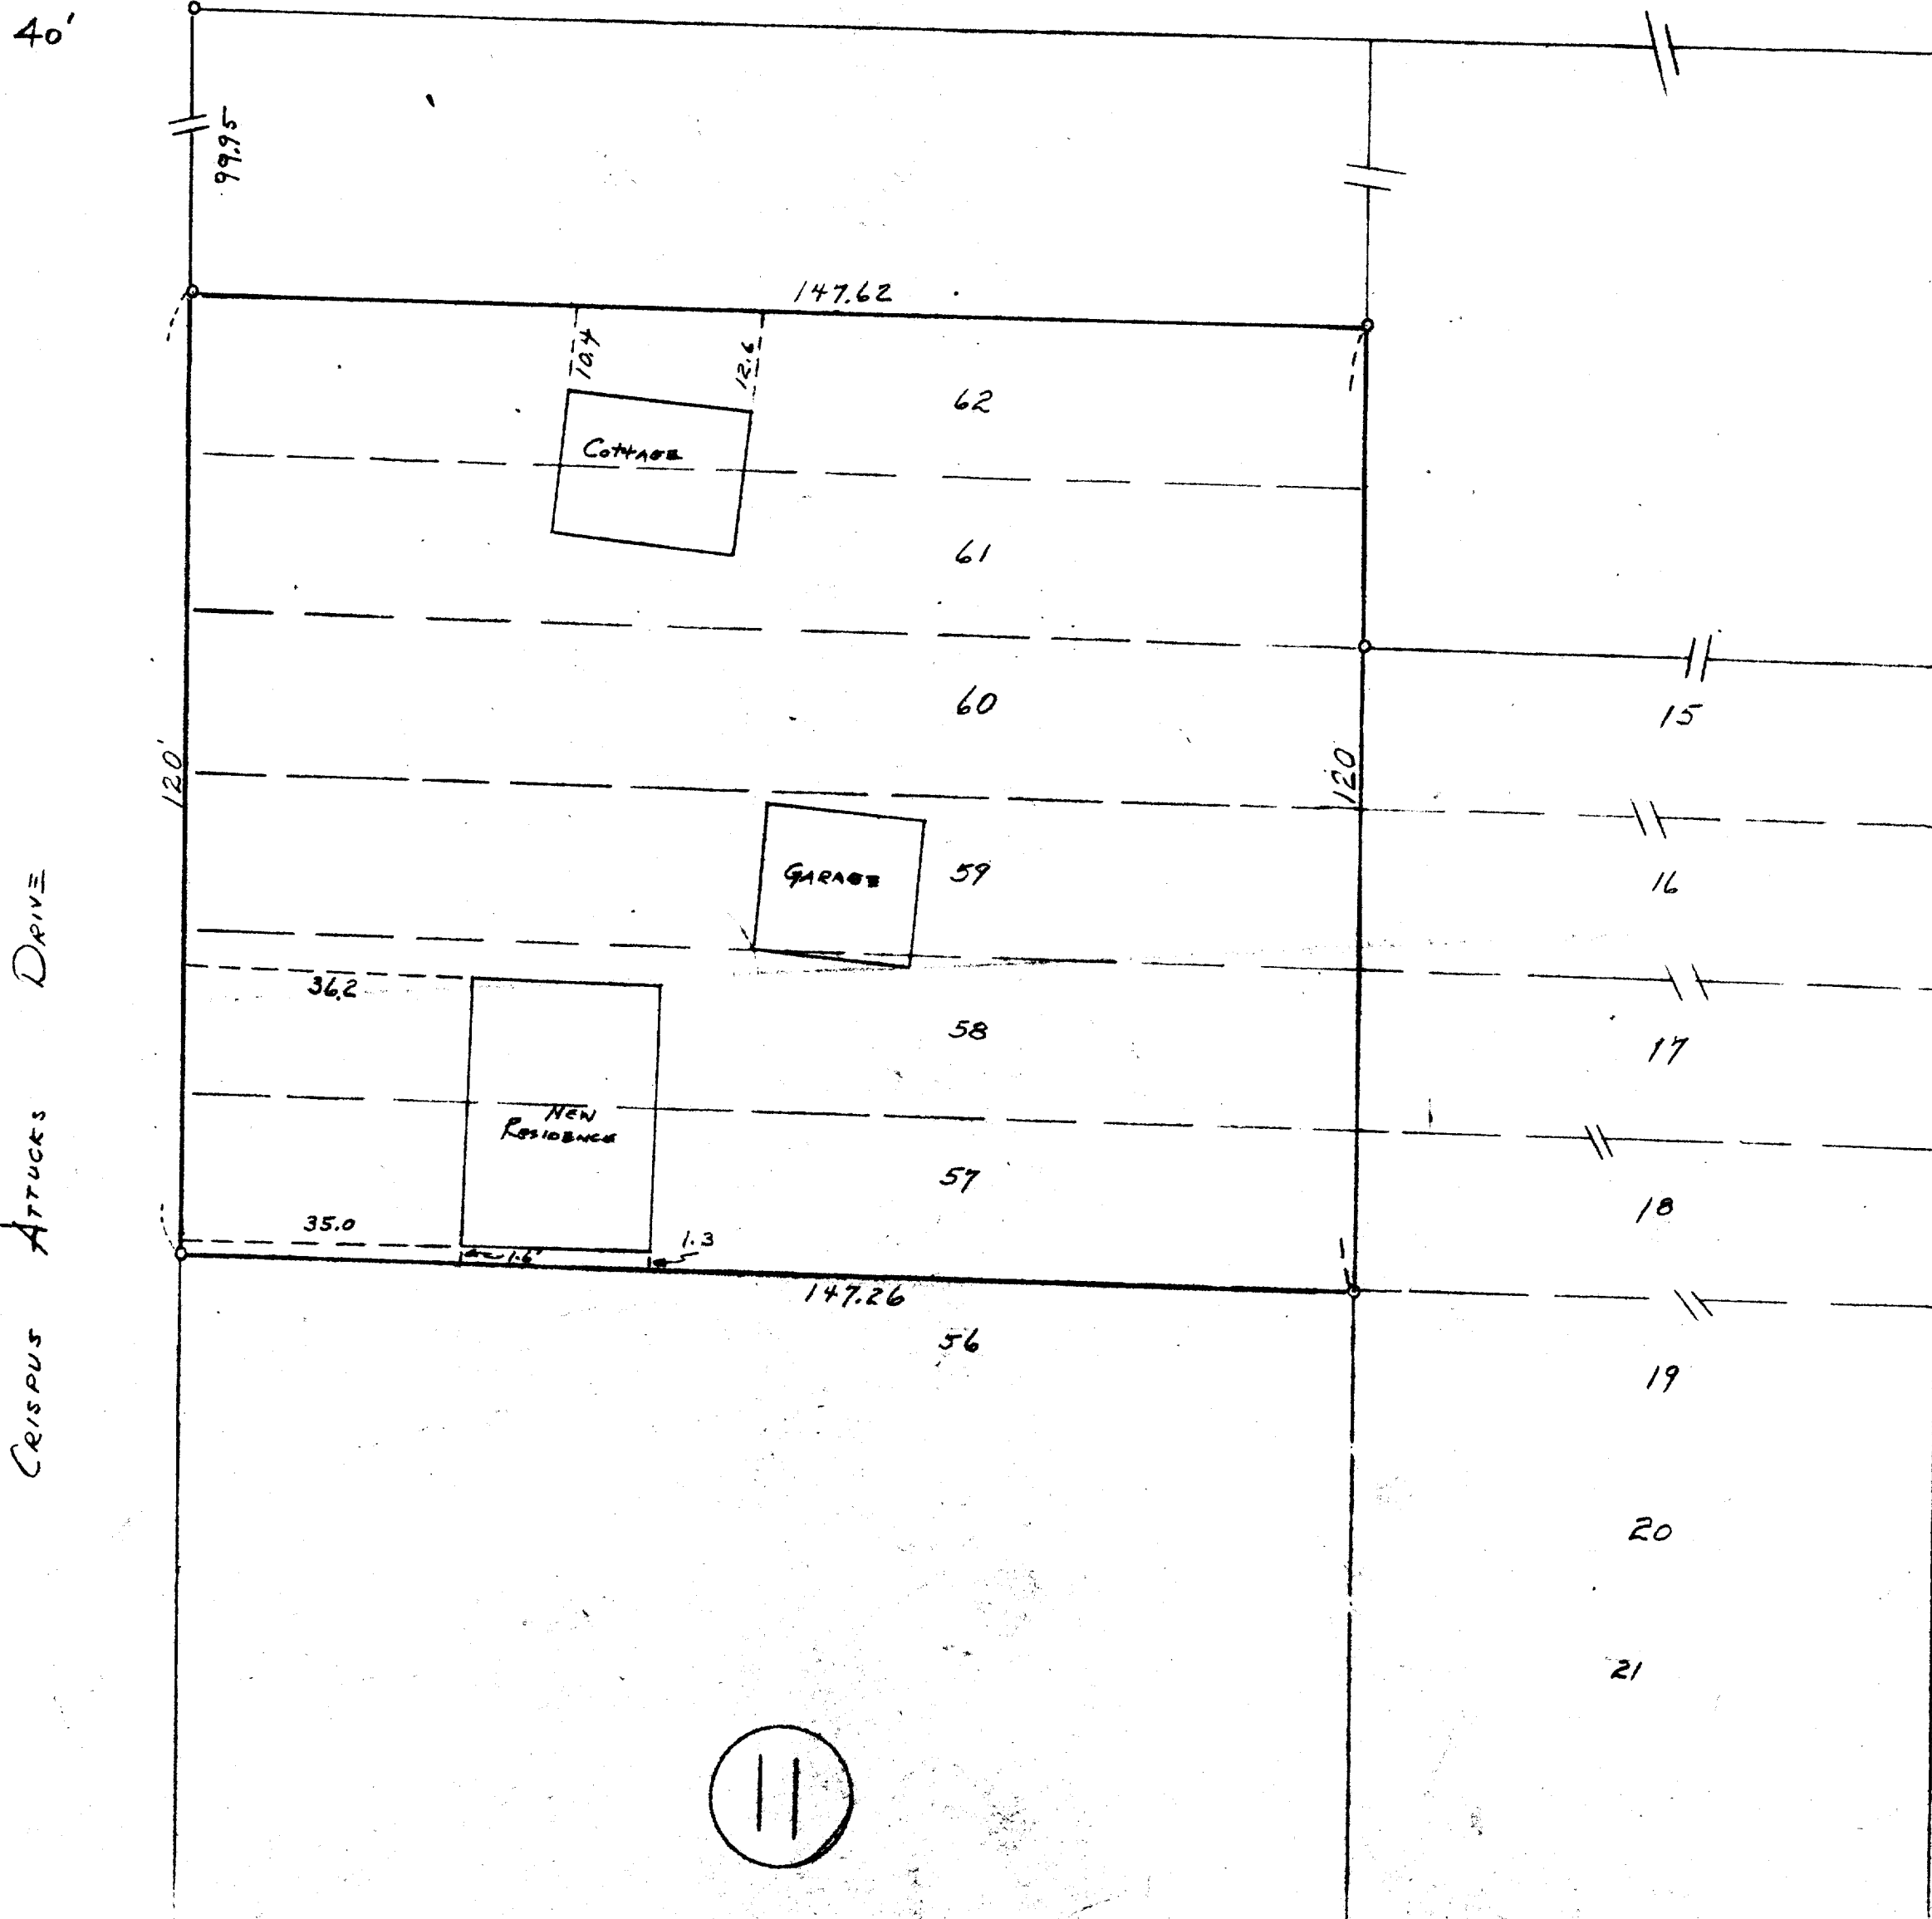

0 - IRON PIPE

(23)

STATE OF WISCONSIN }
COUNTY OF WALWORTH }

I, LLOYD L. JENSEN, DO HEREBY CERTIFY THAT I HAVE SURVEYED THE PROPERTY DESCRIBED HEREON ACCORDING TO THE OFFICIAL RECORDS, AND THAT THE PLAT HEREON IS A CORRECT REPRESENTATION OF THE LOT LINES AND PRINCIPAL LINES OF BUILDINGS THEREON.

ELKHORN, WISCONSIN, MARCH, 1955.

Lloyd L. Jensen
SURVEYOR

PLAT OF SURVEY

OF
LOTS 57-62 OF BLOCK 11 OF
LAKE IVANHOE RESORT
LOCATED IN TIRIBE, WALWORTH
COUNTY, WISCONSIN

Lloyd L. Jensen
SURVEYOR

SCALE 1" = 20'

DATE MARCH 1955