


PLAT
OF
SURVEY

LOT 12, BLOCK 3 OF PART ONE OF THE FIRST ADDITION TO JEFFERSON ISLAND SUBDIVISION, PART
OF THE SOUTHEAST 1/4 OF SECTION 13, T. 1 N., R. 13 E. OF THE 4TH P.M., TOWNSHIP OF
BLOOMFIELD, COUNTY OF WALWORTH, STATE OF WISCONSIN.

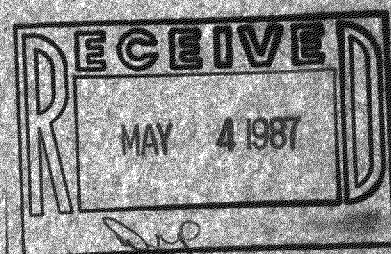

FOR: ROMANO AND KESSLER

SCALE 1" = 30'

Q = IRON PIPE STAKE FOUND.


BEARING DATUM IS THAT OF
RECORDED PLAT.

I have surveyed the above-described property,
and the map hereon is a true representation
thereof and shows the size and location of the
property, its exterior boundaries, the location
and dimensions of all visible structures thereon,
fences, apparent easements and roadways and
visible encroachments, if any.

This survey is made for the exclusive use of
the present owners of the property, and also
those who purchase, mortgage, or guarantee
the title therein, within one year from date
hereof.

Dated at Burlington, Wis. 7th day
of APRIL 1987

John F. Degen
John F. Degen, Land Surveyor & S&L

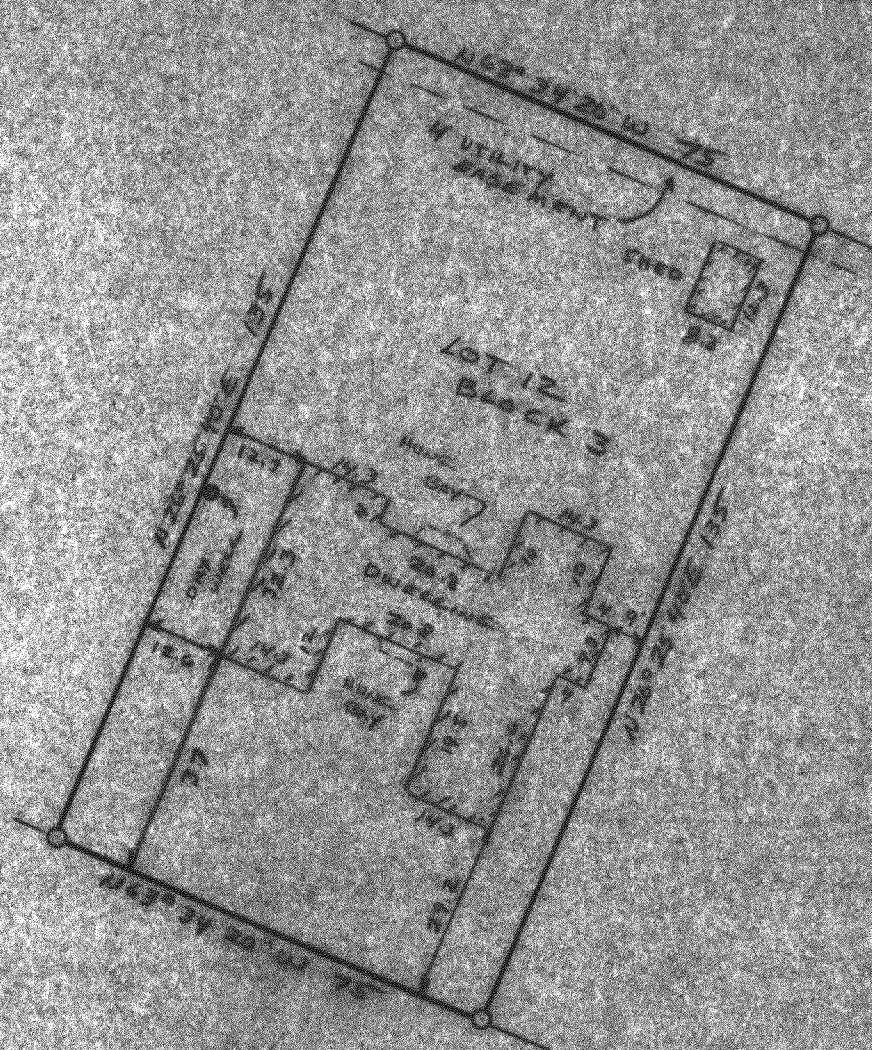

N

← HIPPERCINK ROAD

MT 15-28

118-734