


WALWORTH COUNTY
SURVEYING & MAPPING
LAKE GENEVA, WISCONSIN

ROSEWOOD DRIVE


SANDALWOOD DRIVE

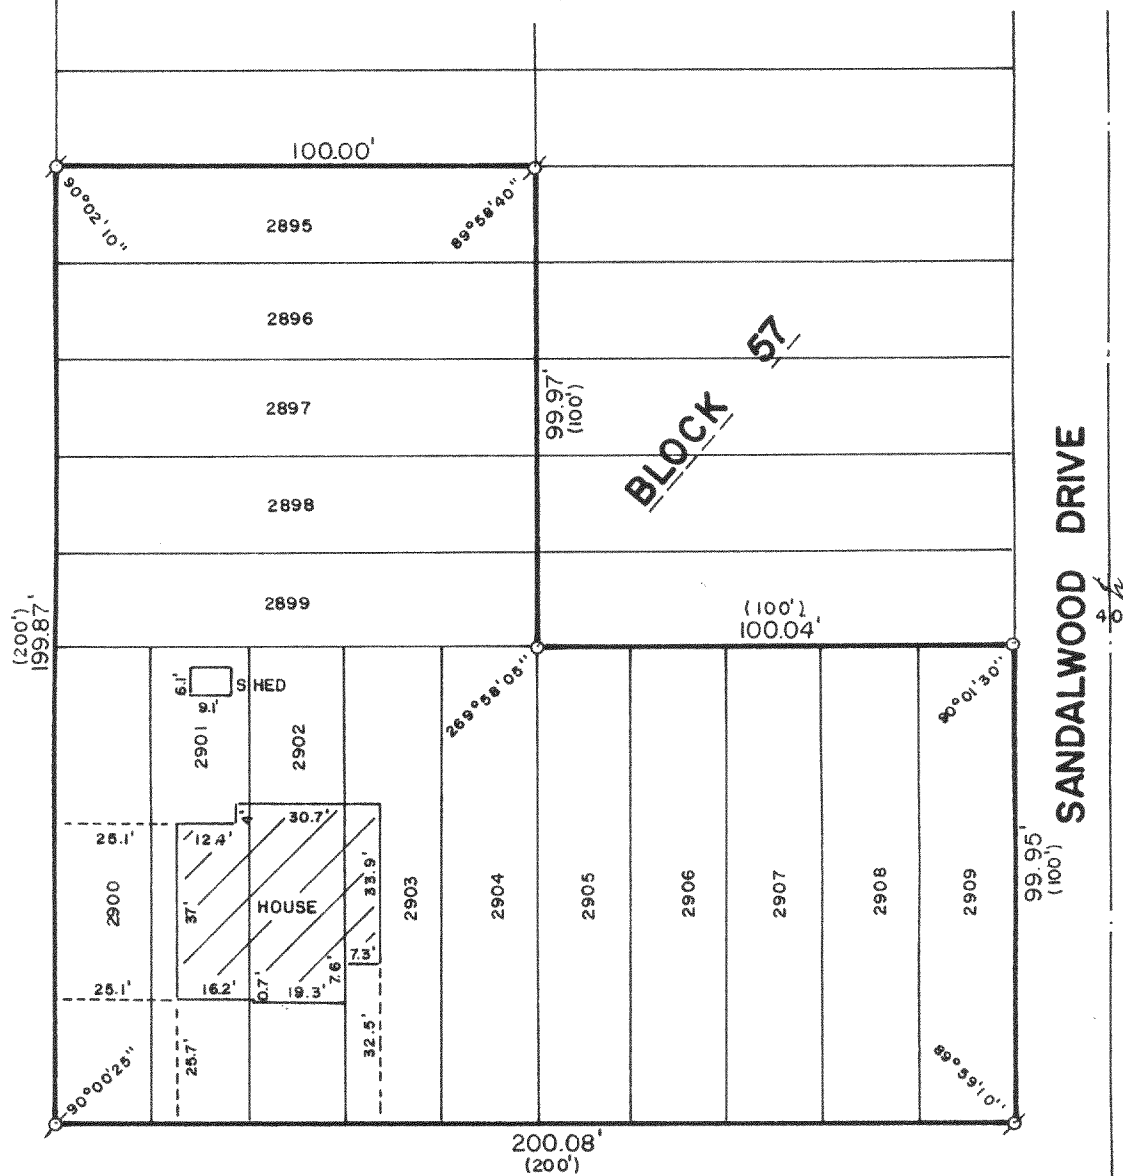


HAWTHORNE ROAD

PLAT OF SURVEY OF

LOTS 2895-2909, BLOCK 57 OF SECTION
2 OF PELL LAKE, A SUBDIVISION LOCATED
IN T 1 N, R 18 E, WALWORTH COUNTY,
WISCONSIN.

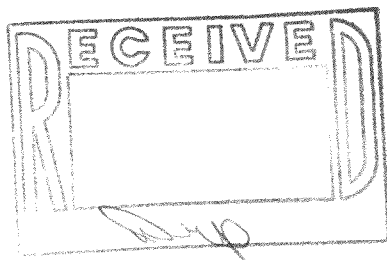

ORDERED BY: CENTURY 21 GENEVA LAKE
503 CENTER STREET
LAKE GENEVA, WISCONSIN
53147

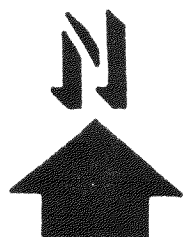

SCALE: 1"=40'

⊕ - IRON PIPE FOUND
○ - IRON ROD PLACED
() - RECORDED AS

I, ROBERT M. BAERENWALD, DO HEREBY CERTIFY THAT I
HAVE SURVEYED THE PROPERTY HEREON DESCRIBED ACCORDING
TO THE OFFICIAL RECORDS AND THAT THE PLAT HEREON IS A
CORRECT REPRESENTATION OF THE PROPERTY LINES TO THE
BEST OF MY KNOWLEDGE AND BELIEF.

Robert M. Baerenwald
ROBERT M. BAERENWALD
WISCONSIN REGISTERED LAND SURVEYOR, S-1508

Sept. 18, 1987
DATE JOB NO. 1262

NOTE: THIS IS NOT A CERTIFIED COPY UNLESS SEALED.

MPL-606, 607, 608

119-701