

PLAT OF SURVEY
OF


LOT 9, BLOCK 1, OF NIPPERSINK PARK, A SUBDIVISION LOCATED IN THE NE 1/4 OF SECTION
24, T. 1 N., R. 18 E. OF THE 4TH P.M., TOWNSHIP OF BLOOMFIELD, WALWORTH COUNTY, WI.

FOR: POTER

SCALE 1" = 30'

Ø = IRON PIPE STAKE FOUND.

BEARING DATUM IS THAT OF RECORDED PLAT.

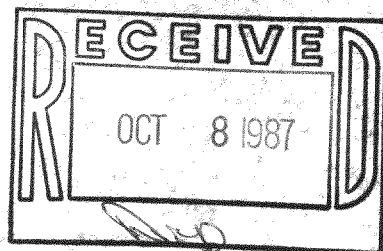

I have surveyed the above-described property,
and the map herein is a true representation
thereof and shows the site and location of the
property, its exterior boundaries, the location
and dimensions of all visible structures thereon,
fences, apparent easements and roadways and
visible encroachments, if any.

This survey is made for the exclusive use of
the present owners of the property, and also
those who purchase, mortgage, or guarantee
the title thereto, within one year from date
hereof.

Dated at Burlington, this 15th day
of SEPTEMBER, 1987

John F. Degen
John F. Degen, Land Surveyor S 242

