


WALWORTH COUNTY
SURVEYING & MAPPING
LAKE GENEVA, WISCONSIN



GERANIUM ROAD

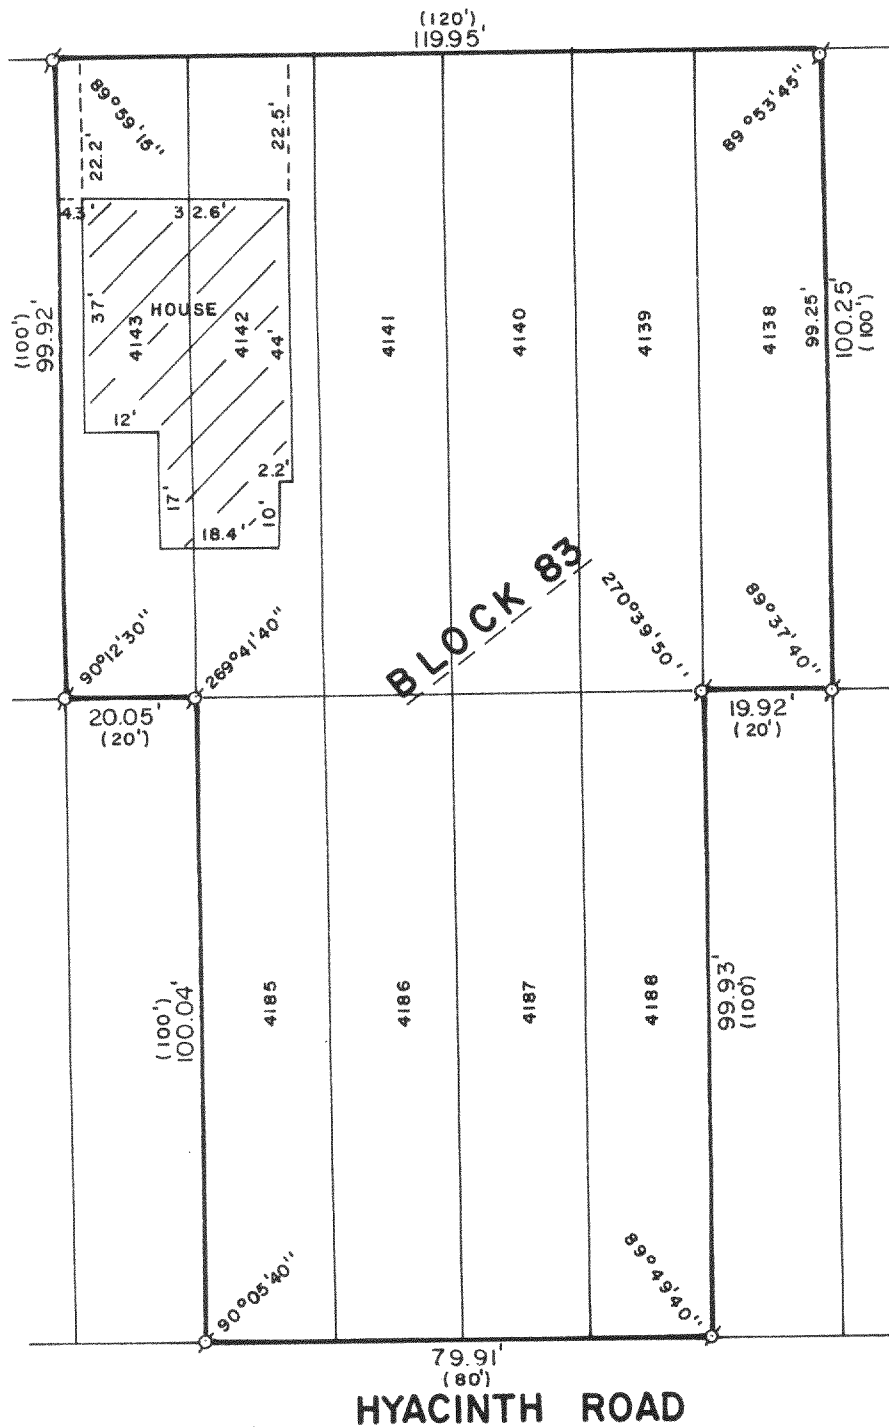

PLAT OF SURVEY OF

LOTS 4138-4143 AND 4185-4188,
BLOCK 83 OF SECTION 3 OF PELL
LAKE, A SUBDIVISION LOCATED IN
T 1 N, R 18 E, WALWORTH COUNTY,
WISCONSIN.

ORDERED BY: REALTY WORLD-TAGGART
736 MAIN STREET
LAKE GENEVA, WI
53147

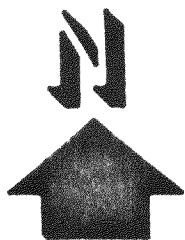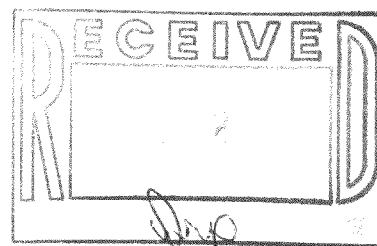

SCALE: 1"=30'

⊗ - IRON PIPE FOUND
() - RECORDED AS

I, ROBERT M. BAERENWALD, DO HEREBY CERTIFY THAT I
HAVE SURVEYED THE PROPERTY HEREON DESCRIBED ACCORDING
TO THE OFFICIAL RECORDS AND THAT THE PLAT HEREON IS A
CORRECT REPRESENTATION OF THE PROPERTY LINES TO THE
BEST OF MY KNOWLEDGE AND BELIEF.

Robert M. Baerenwald
ROBERT M. BAERENWALD
WISCONSIN REGISTERED LAND SURVEYOR, S-1508

Nov. 19, 1987
DATE JOB NO. 1345

NOTE: THIS IS NOT A CERTIFIED COPY UNLESS SEALED.

MPL-863.882

118-717