


DUNHAM & RASMUSSEN
SURVEYING & ENGINEERING
DELAVER, WISCONSIN



Scale - 1" = 20'
O = Iron Pipe

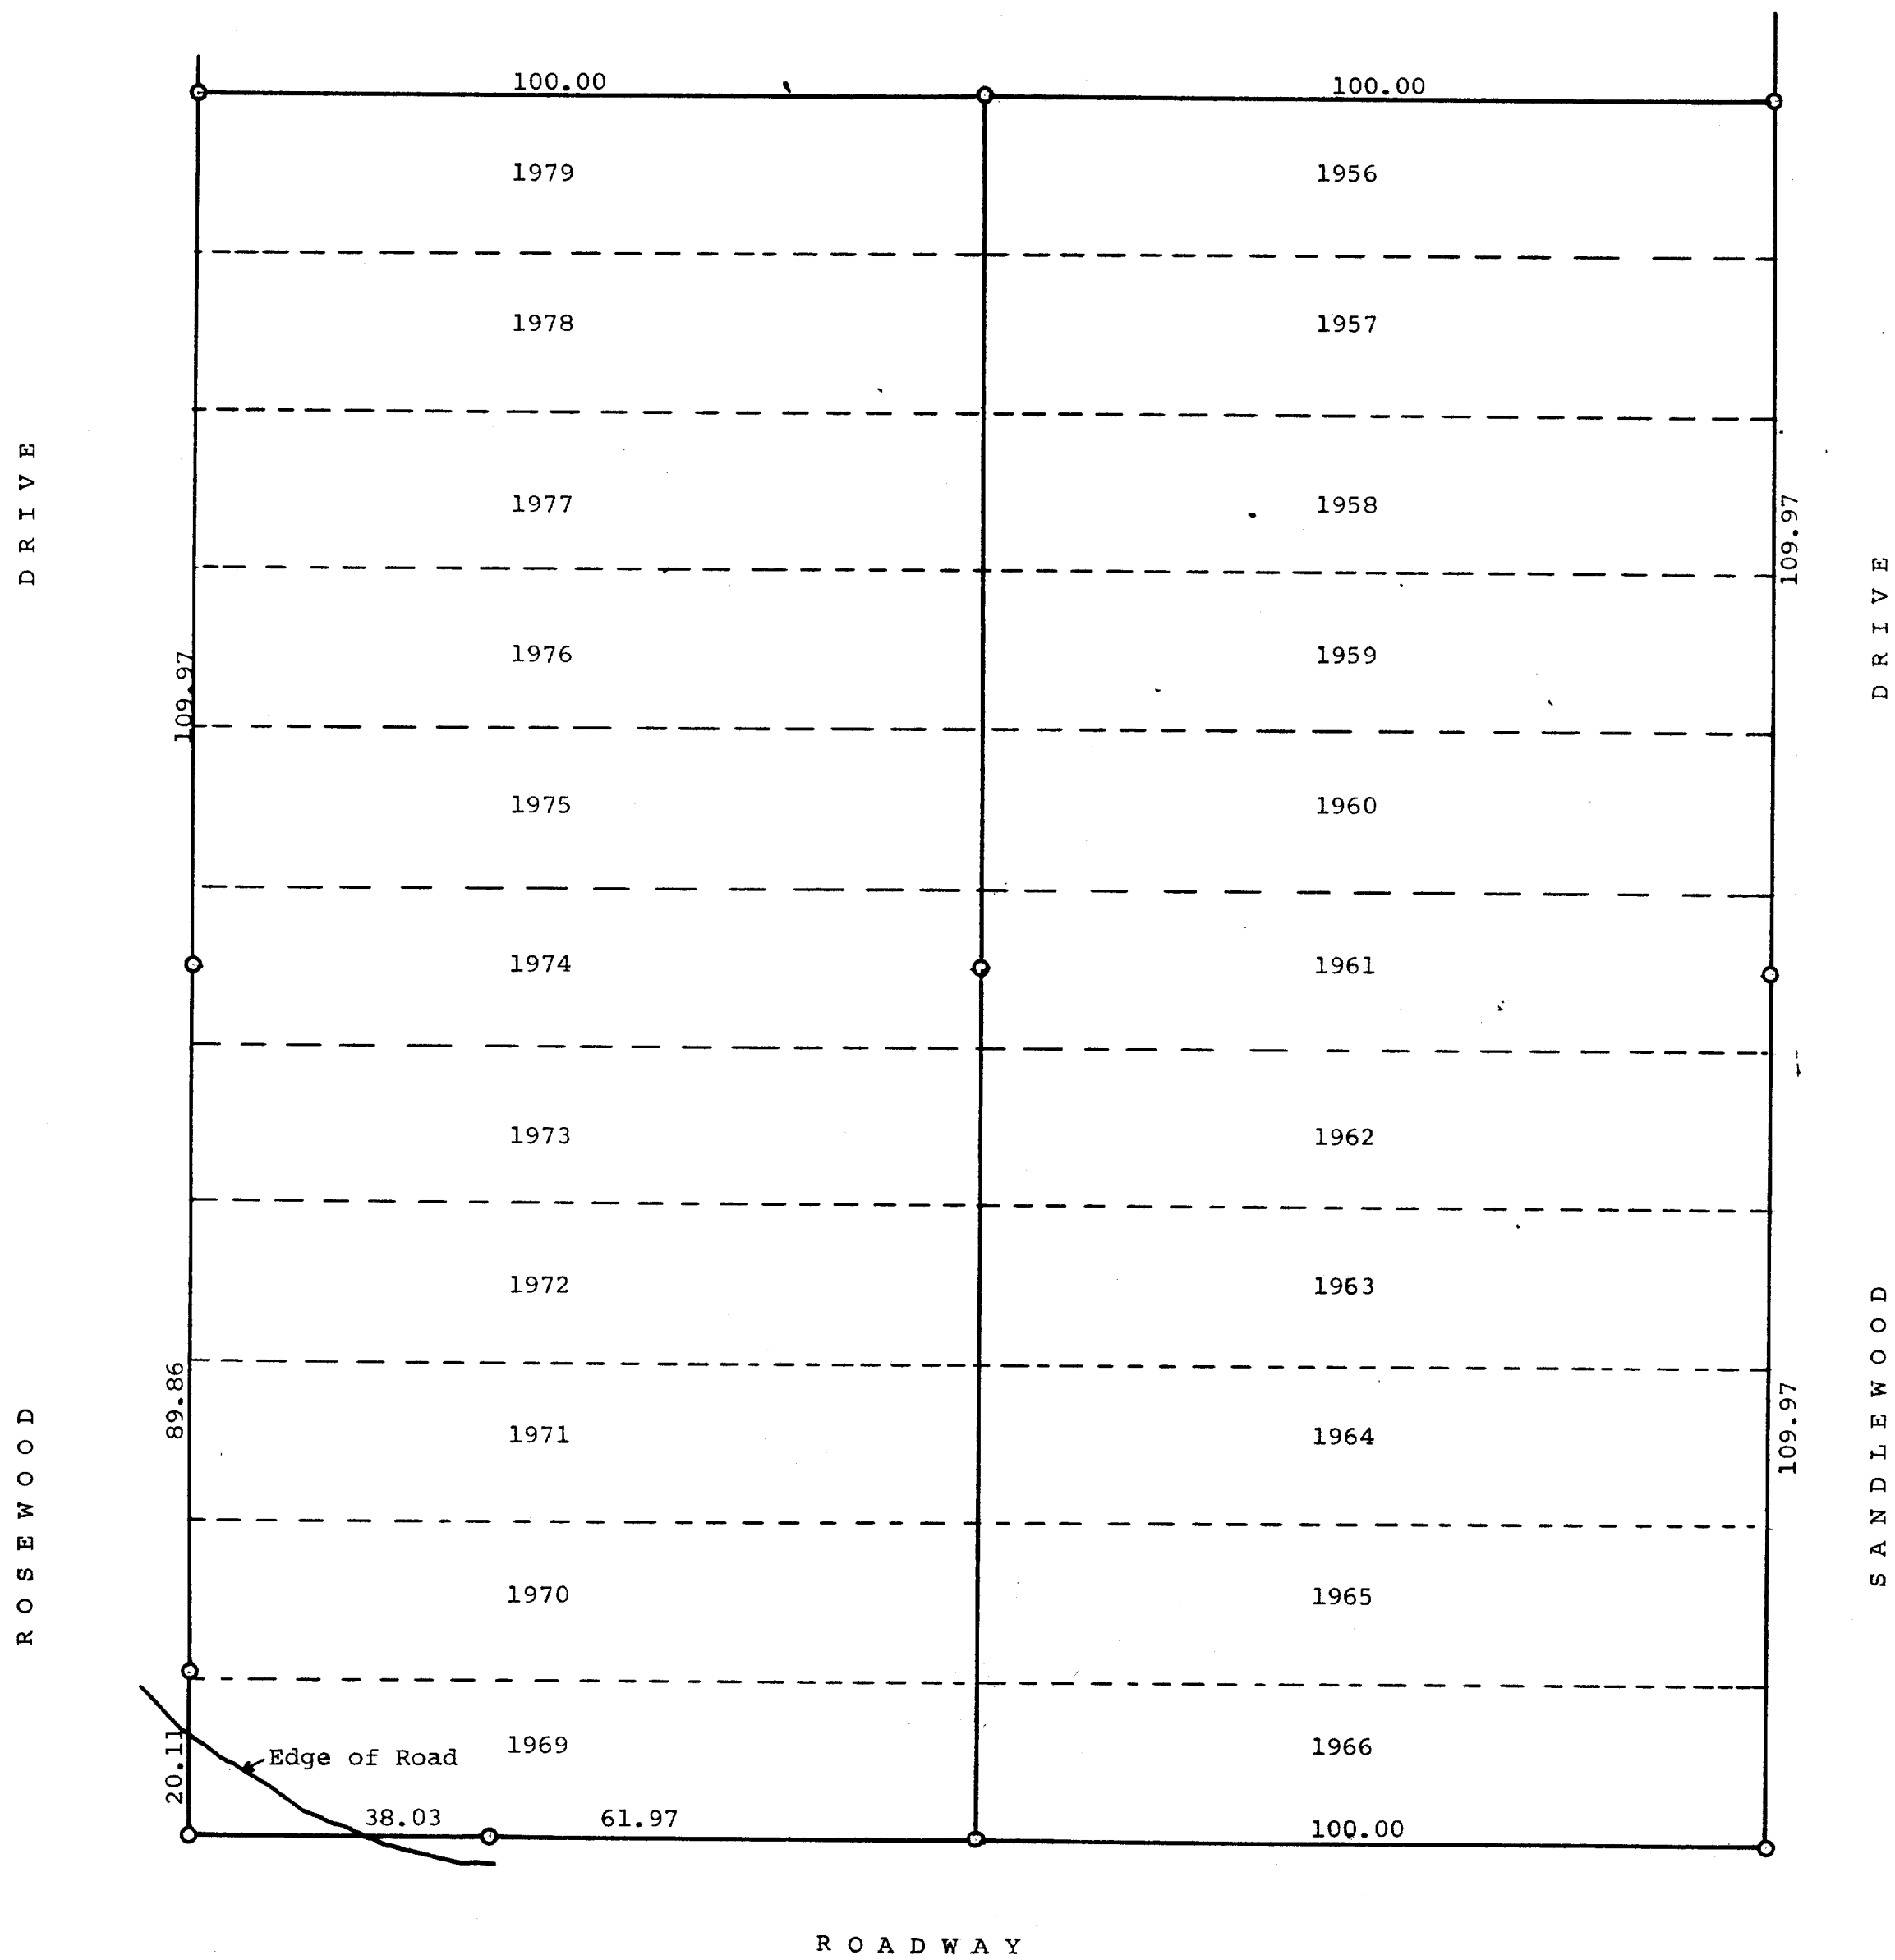

Plat of survey of Lots 1956-1966 Inclusive and of Lots 1969-1971
Inclusive of Pell Lake Subdivisions, Town of Bloomfield, Walworth
County, Wisconsin.
April 20, 1962

George T. Dunham
George T. Dunham, Surveyor