


M A R I N E T T E

R O A D

N

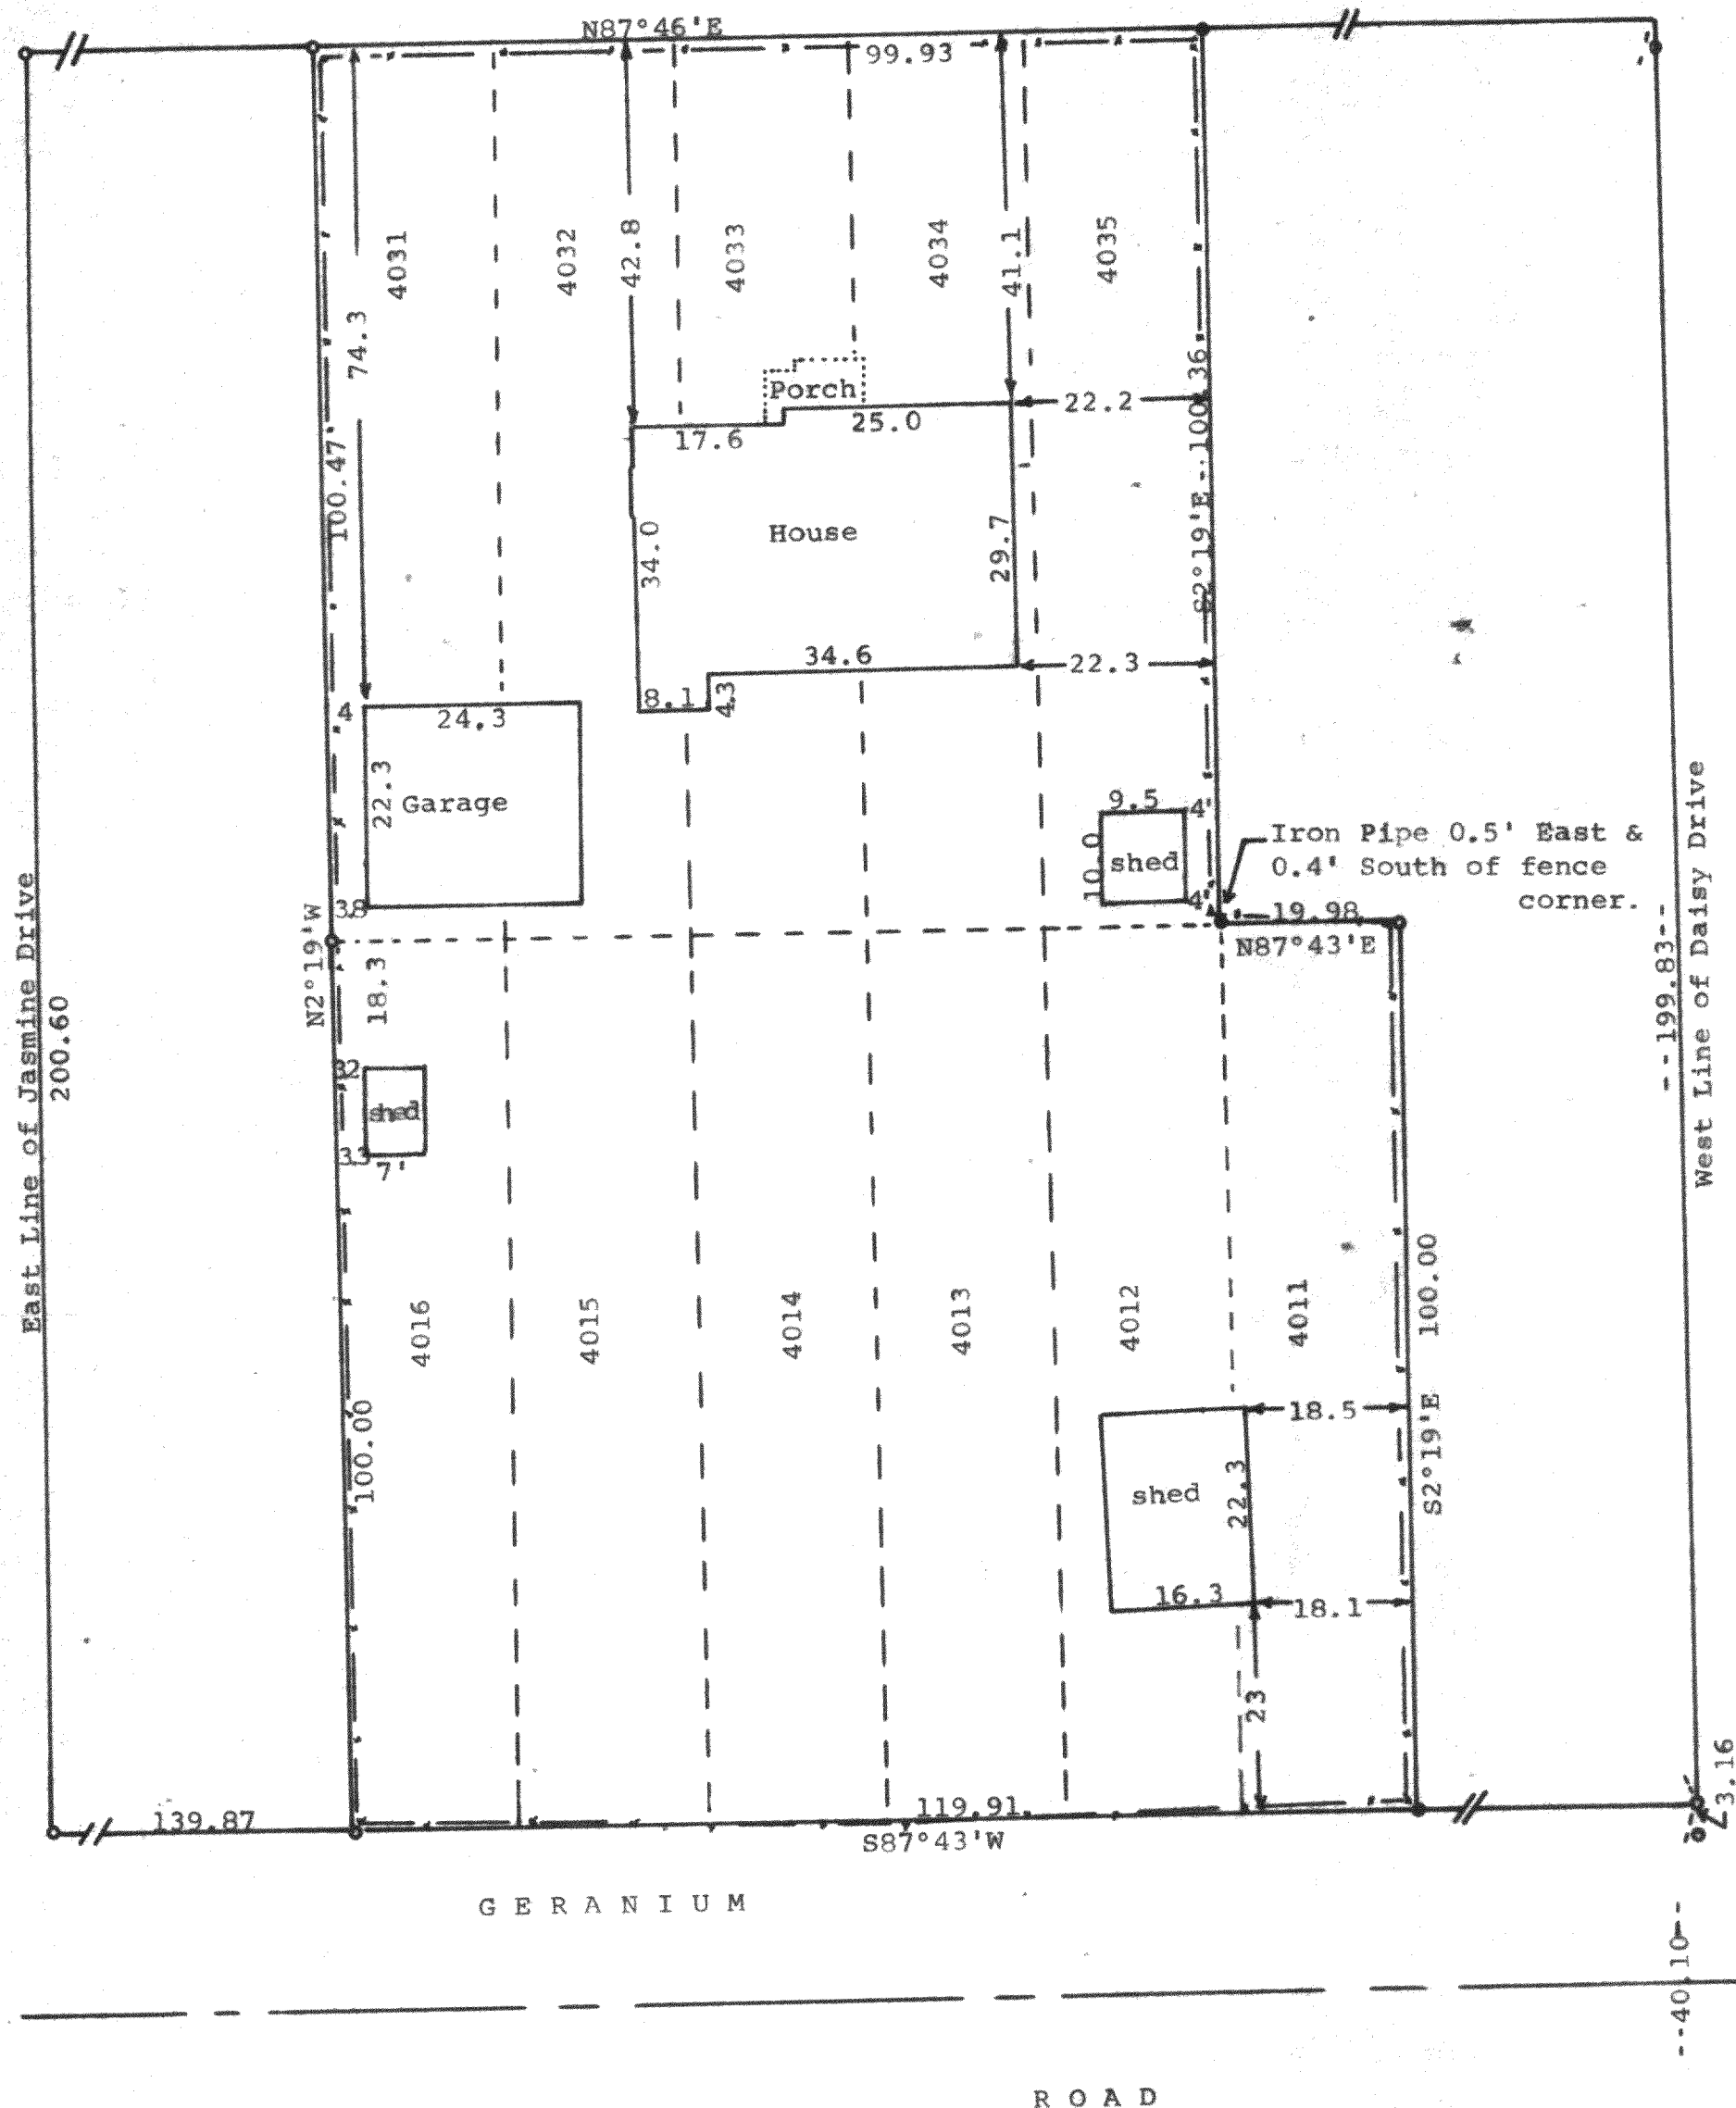

Scale - 1" = 20'

● = 1" Iron Pipe Found
● = 3/4" Iron Pipe Found

Fence Line

Bearings referenced to the recorded bearing of N87°46'E along the south line of Marinette Drive
Survey ordered by:
Barb Lepkowski, Realtor
484 Orchard Street
Antioch, IL 60002

STATE OF WISCONSIN)
COUNTY OF WALWORTH) SS

I, George T. Dunham, Surveyor, certify that I have surveyed the property described as follows:

Lots 4011 through 4016, inclusive and Lots 4031 through 4035, inclusive all in Block 81 of Section 3 of Pell Lake Subdivision, located in Section 15, T 1 N, R 18 E, Walworth County, Wisconsin, and that the map shown hereon, is a correct representation thereof and shows the size and location of the property, its exterior boundaries, the location of all visible structures and dimensions of all principal buildings thereon, boundary fences, apparent easements, roadways and visible encroachments, if any, and that I have surveyed the property hereon described, according to the official records, to the best of my knowledge and belief.

November 24, 1987

George T. Dunham
George T. Dunham, Surveyor

