


GEORGE T. DUNHAM
SURVEYING & SUBDIVIDING
DELAVAN, WISCONSIN

Scale - 1" = 20'
O = Iron Pipe

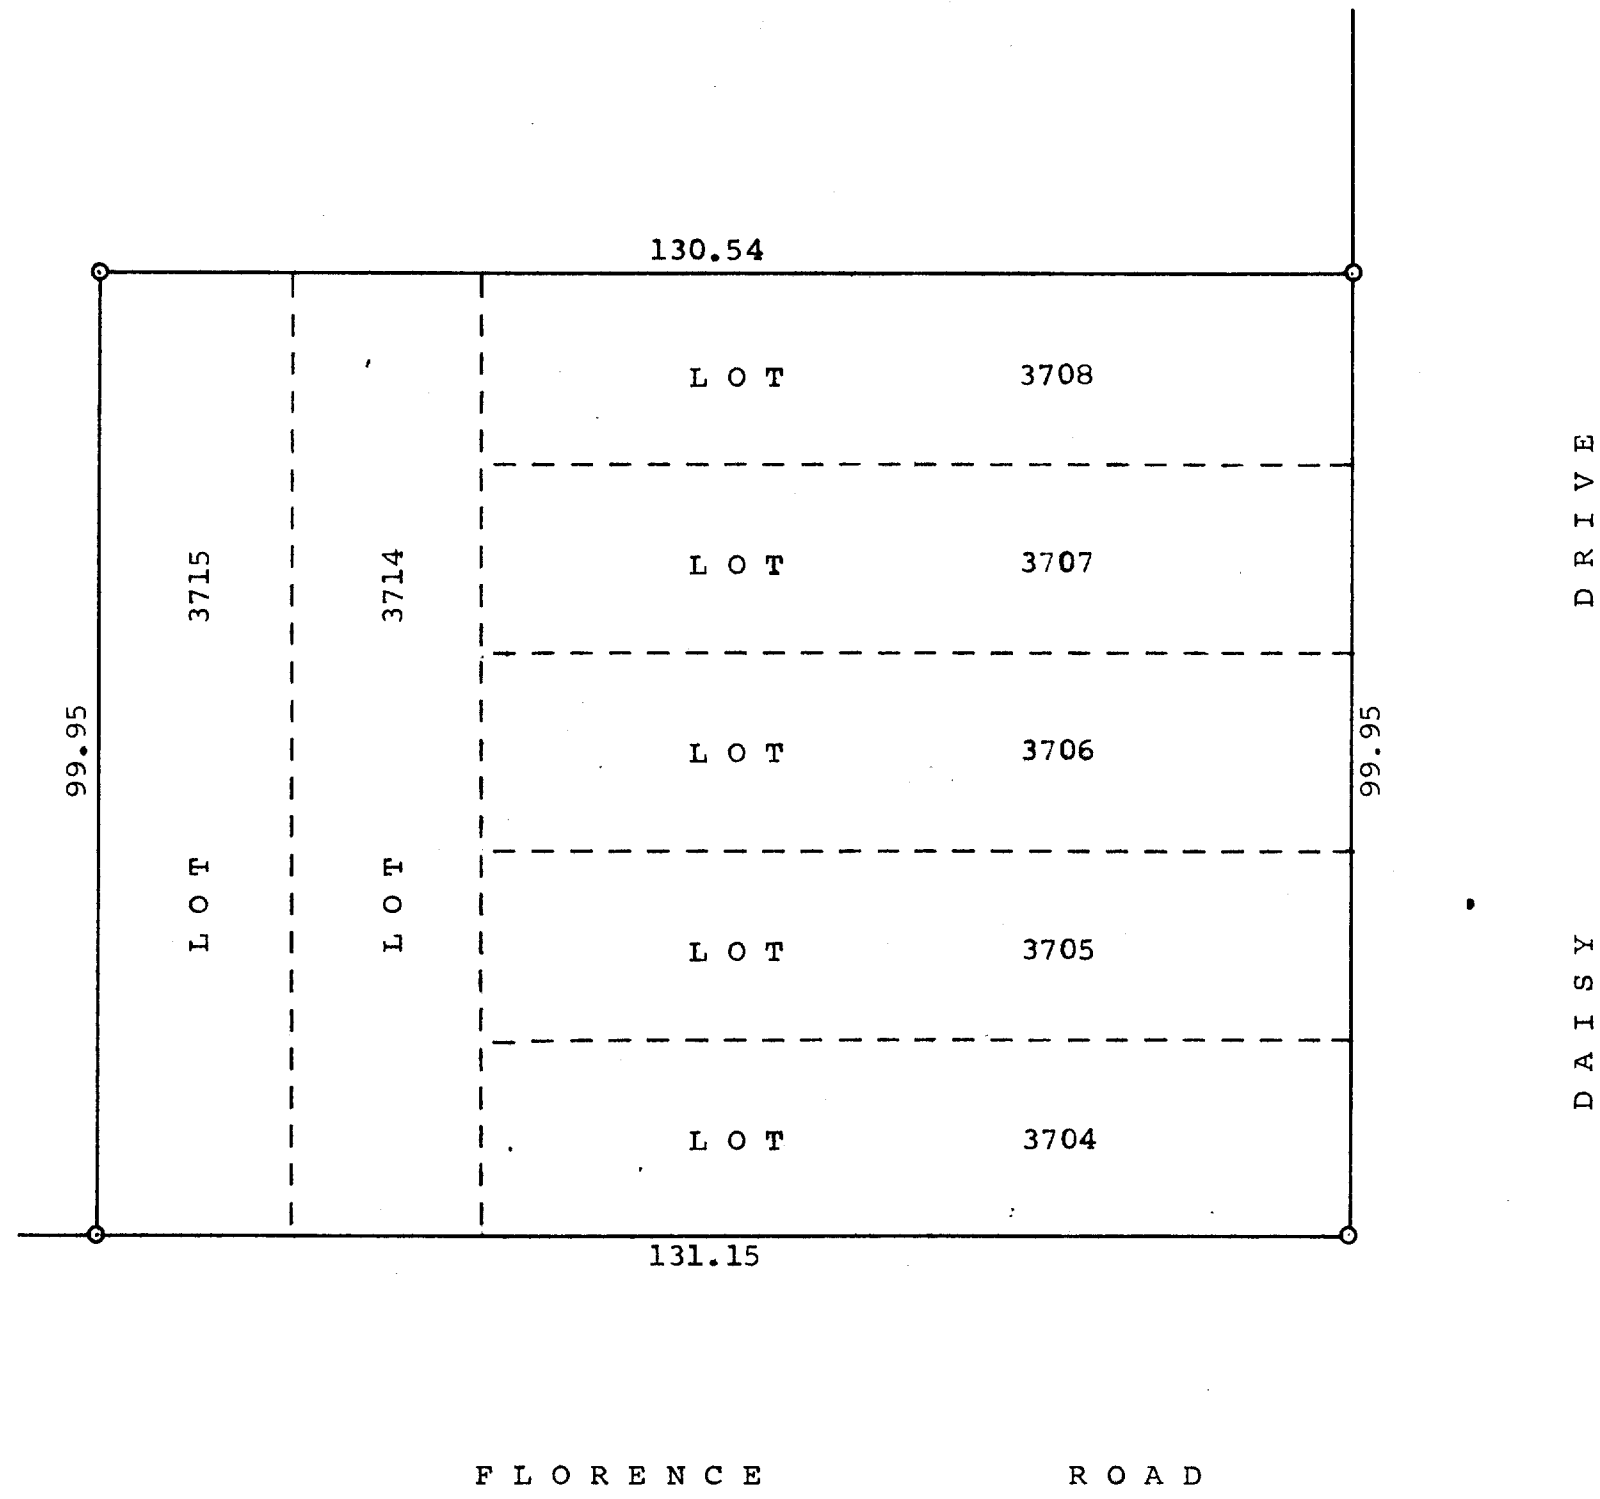

Plat of survey of Lots 3704-3708 and 3714-3715
of Pell Lake Subdivision, T 1 N R 18 E, Walworth County,
Wisconsin.
August 15, 1962

George T. Dunham
George T. Dunham, Surveyor