


ALL THAT PART OF THE SOUTHEAST 1/4 OF SECTION 13, T. 1 N., R. 18 E. TOWN OF BLOOMFIELD, WALWORTH COUNTY, WIS CONSIDERED AS FOLLOWS: BEGIN AT AN OAK STAKE IN THE CENTER OF SAID SECTION 13, RUN THENCE EAST ON THE CENTER LINE OF SAID SECTION 957.40 FEET TO THE CENTER OF A PUBLIC ROAD; RUN THENCE S. 30°31' W., 164 FEET TO A POINT WHICH IS THE PLACE OF BEGINNING OF PARCEL OF LAND HEREBY CONVEYED; RUN THENCE N. 30°31' E., ALONG CENTER OF HIGHWAY 60 FEET; THENCE N. 87°22' W., 210 FEET TO A POINT THENCE SOUTHERLY AND TO A POINT WHICH IS 190 FEET DUE WEST FROM THE PLACE OF BEGINNING; THENCE EAST 190 FEET TO THE PLACE OF BEGINNING. SAID PARCEL IS ALSO KNOWN AS LOT 18 OF THE ZUHDE SUBDIVISION. TOGETHER WITH A RIGHT OF WAY IN COMMON WITH GRANTOR AND OTHERS FOR FOOT PASSAGE FROM THE ABOVE DESCRIBED HIGHWAY TO POWERS LAKE OVER AND ACROSS THE NORTH 35 FEET OF PREMISES OWNED BY THE PARTY OF THE FIRST PART AND PARTICULARLY DESCRIBED IN WARRANTY DEED FROM WILLIAM ELLIOT AND ROSE A. HIS WIFE TO HENRIETTA ZUHDE DATED JUNE 3, 1921 RECORDED JUNE 7, 1921 IN VOL. 163 OF DEEDS ON PAGE 272. ALSO A RIGHT OF WAY IN COMMON WITH OTHERS OVER A STRIP OF LAND 15 FEET IN WIDTH FROM THE ABOVE DESCRIBED PREMISES NORTH AND EAST TO SAID PUBLIC HIGHWAY THE SOUTHERLY AND EASTERLY LINE OF SAID RIGHT OF WAY BEING PARTICULARLY DESCRIBED AS FOLLOWS: COMMENCING AT THE NORTHWEST CORNER OF THE PREMISES ABOVE DESCRIBED, RUN THENCE S. 87°22' E., 30 FEET; THENCE N. 30°45' E., 150 FEET; THENCE S. S. 88°13' E., 180 FEET TO THE CENTER OF THE HIGHWAY.

ADJWAY - ZUHDE PLAT
N. 27°10' E
E. AS N 30°45' E 157.5
150

BEARINGS RELATE TO SOUTH LINE OF LOT 18
WHICH WAS USED AS. S. 89°03' E.

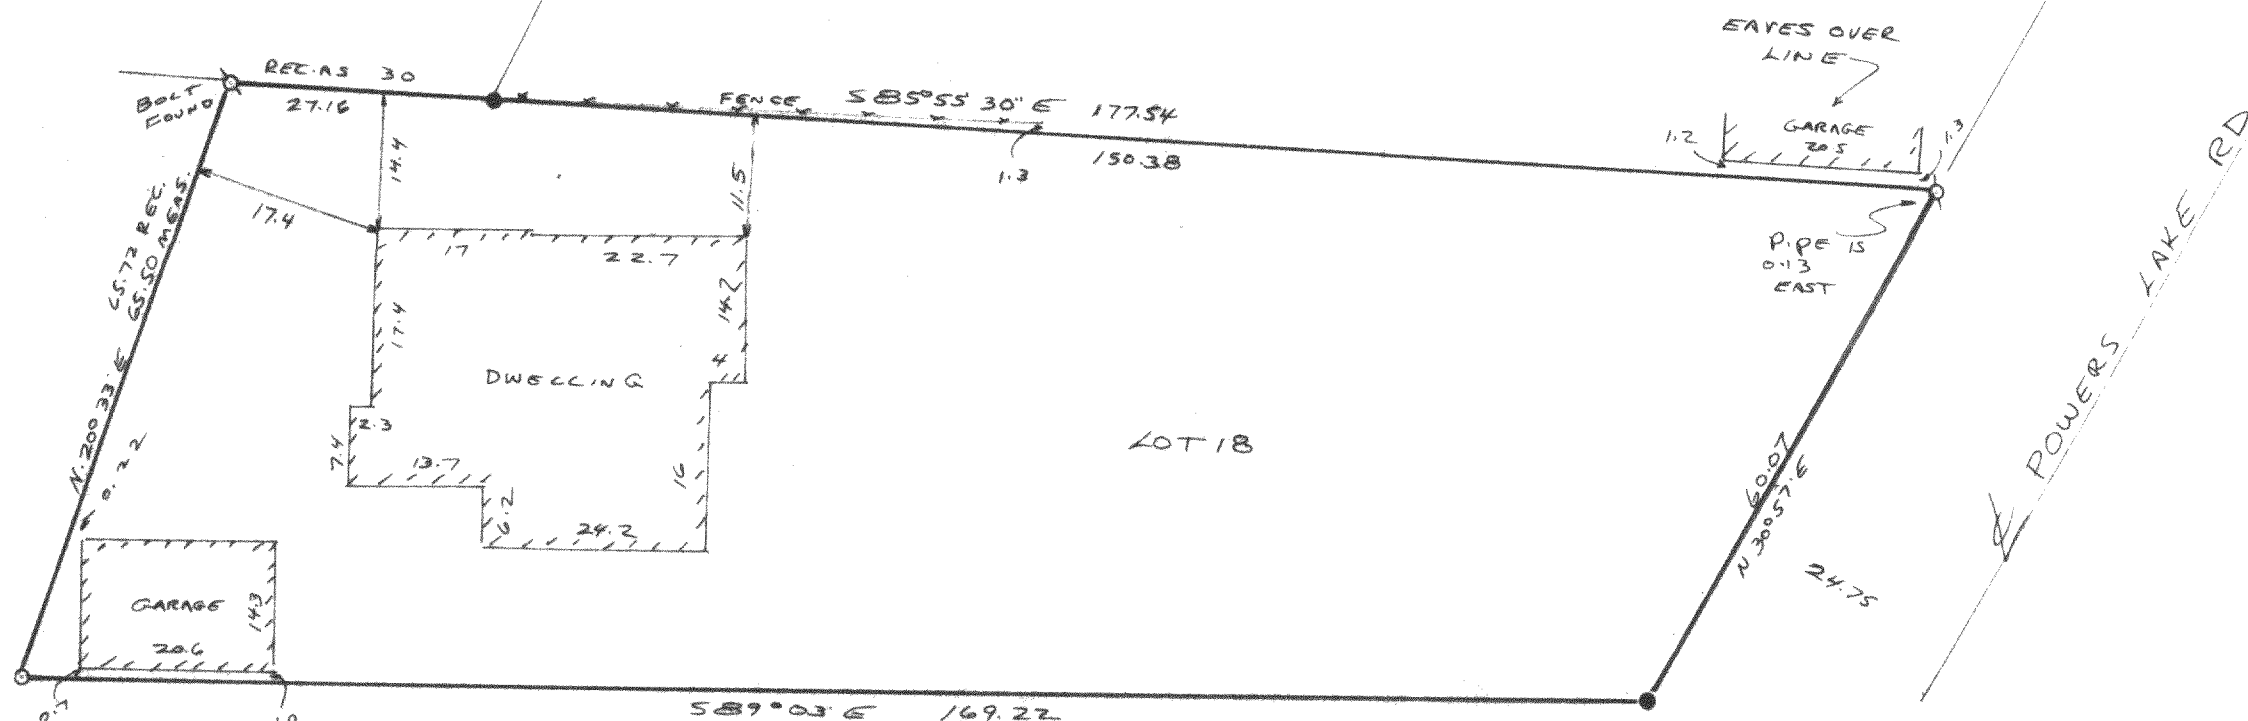

RECEIVED
NOV 23 1966

I have surveyed the above-described property, and the map hereon is a true representation thereof and shows the size and location of the property, its exterior boundaries, the location and dimensions of all visible structures thereon, fences, apparent encroachments and roadways and visible attachments, if any.

This survey is made for the exclusive use of the present owners of the property, and also those who purchase, mortgage, or guarantee the title thereto, within one year from date hereof.

Dated at Burlington, this 12th day
of May, 1988
John F. Degen
John F. Degen, Land Surveyor S-242
589 N. Pine St. Burlington, WI 53105