

PLAT OF SURVEY  
OF

LAKE ACCESS PARCEL DESCRIBED AS BEING THE NORTH 35 FEET OF THE PREMISES DESCRIBED IN VOLUME 163 ON PAGE 272 AND ALSO BEING THE NORTH 35 FEET OF THE SOUTH 75 OF LOT 25 WILLIAM ELLIOT'S POWERS LAKE SUBDIVISION (AS MEASURED ALONG WEST LINE OF LOT 25). SAID LAND BEING IN THE NORTHEAST 1/4 OF SECTION 13, T. 1 N., R. 18 E. OF THE 4TH P.M., TOWNSHIP OF BLOOMFIELD, WAINWORTH COUNTY, WI.


BEARINGS RELATE TO WM. ELLIOT'S SUB

FOR: CENTURY 21 REALTY

SCALE 1" = 10'

o = IRON PIPE STAKE

*John F. Degan*  
5-12-88

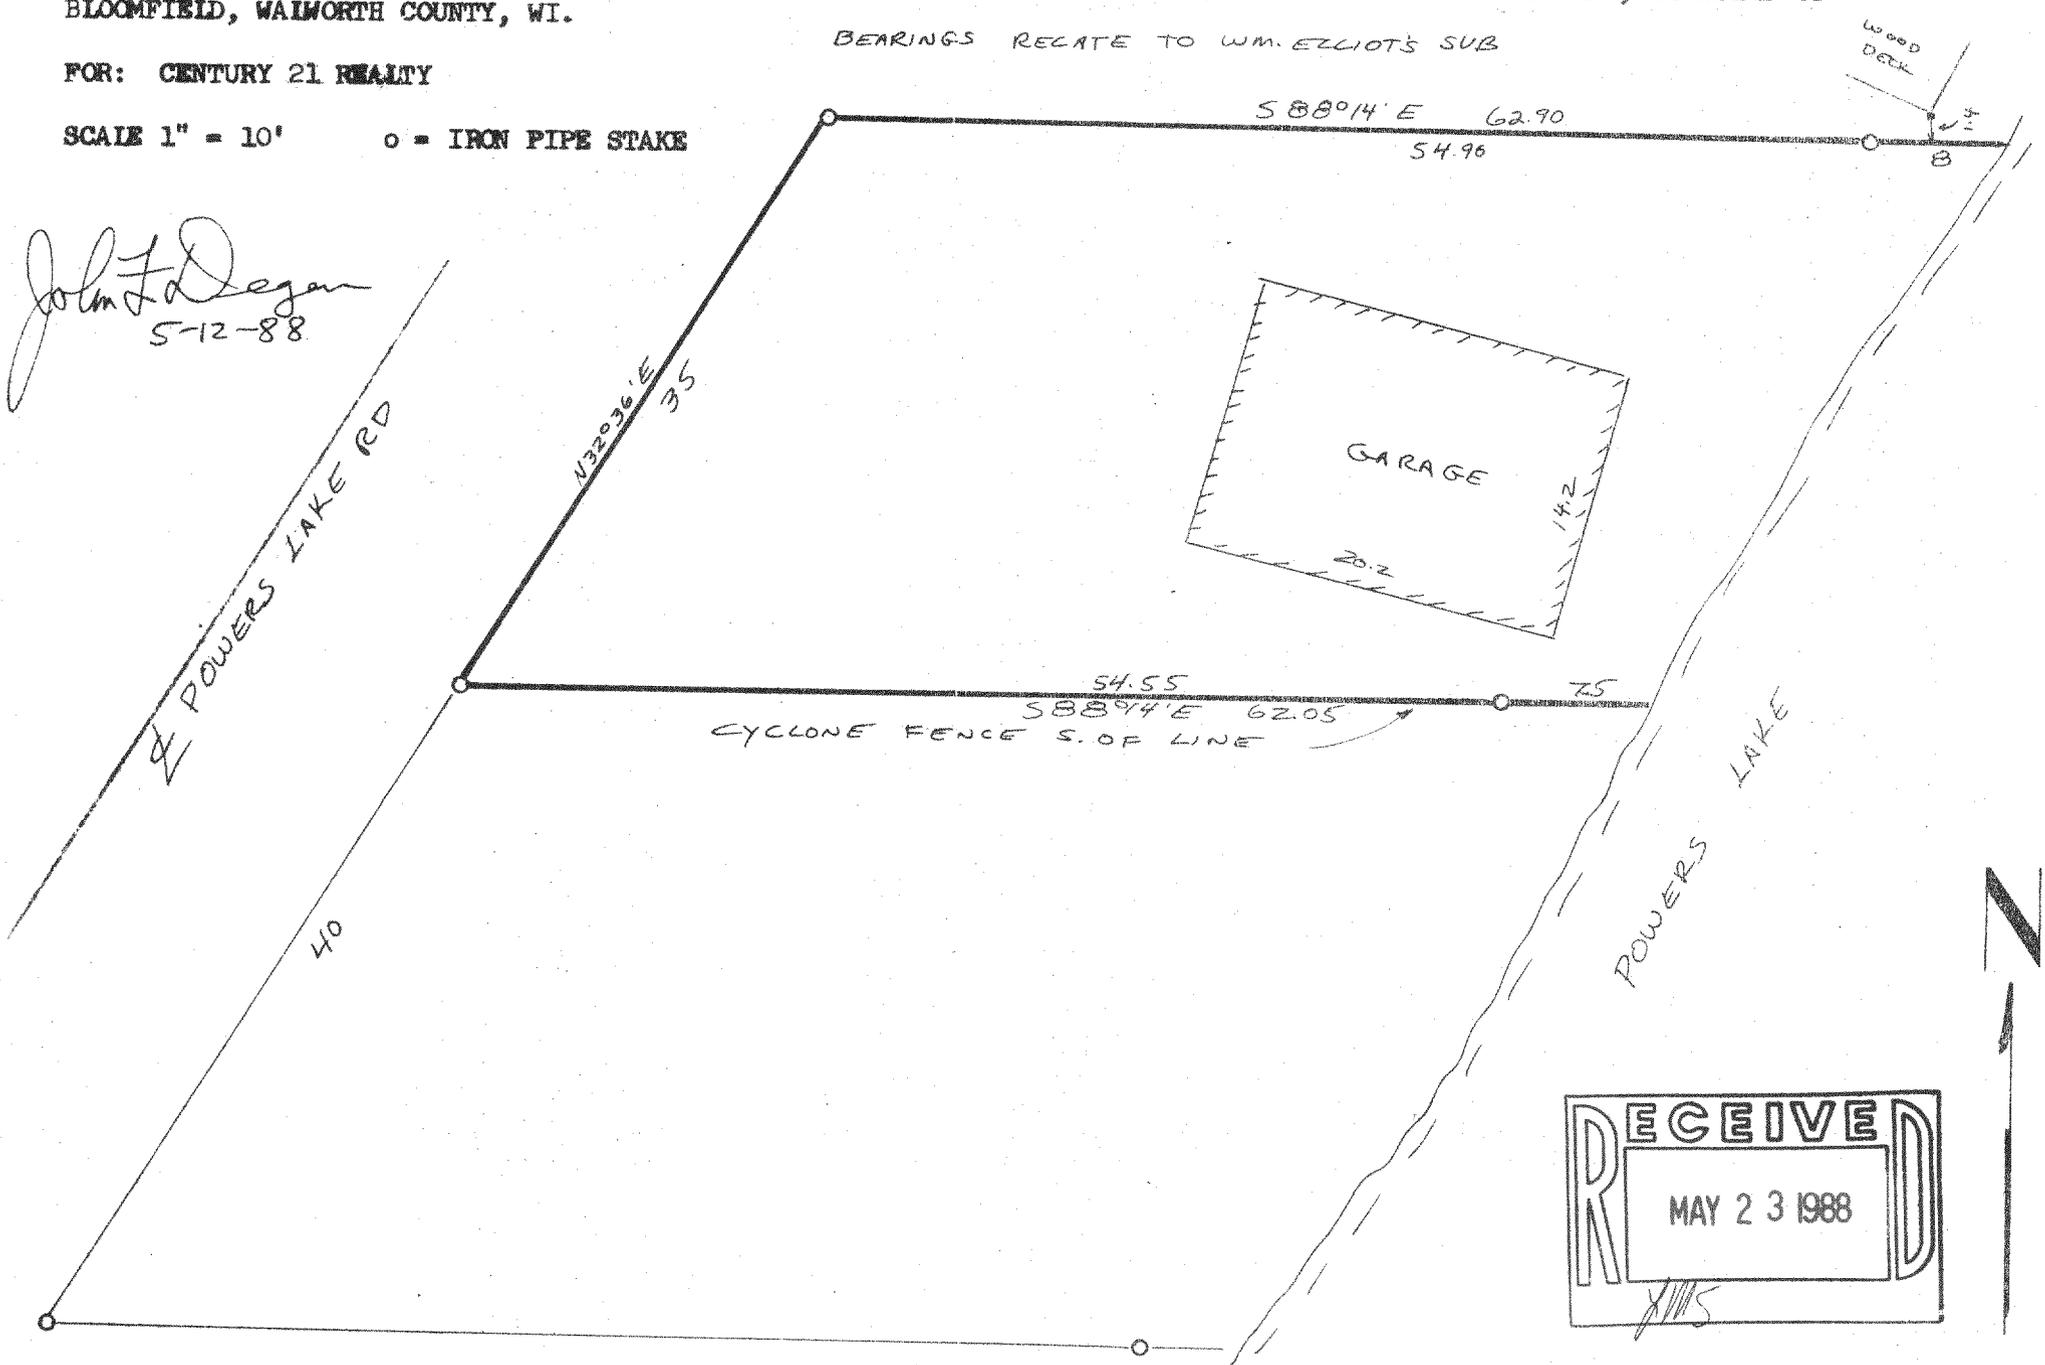

RECEIVED  
MAY 23 1988

SEA 1-EI-91

ME-29

118702