

LAND SURVEYING • SUBDIVIDING • LAND PLANNING

LAKE GENEVA, WISCONSIN 53147


414-248-3697



Ø - IRON PIPE FOUND
O - 1" X 24" IRON PIPE SET

SCALE: 1" = 50'

LOTS 509-10, 531-32, AND 538-42, BLOCK 10,
OF THE PELL LAKE SUBDIVISION, TOWN OF BLOOM-
FIELD, WALWORTH COUNTY, WISCONSIN.

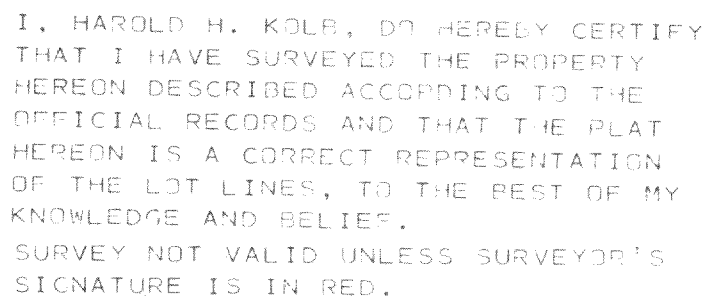

WISCONSIN REGISTERED LAND SURVEYOR, S-187

DATE NOVEMBER 5, 1986

REVISÉD

REVISÉD