


KOLB LAND CONSULTING, INC.
LAND SURVEYING • SUBDIVIDING • LAND PLANNING

929 WILLIAMS STREET LAKE GENEVA, WISCONSIN 53147 414-248-3697

CHESTNUT ROAD 40' WIDE

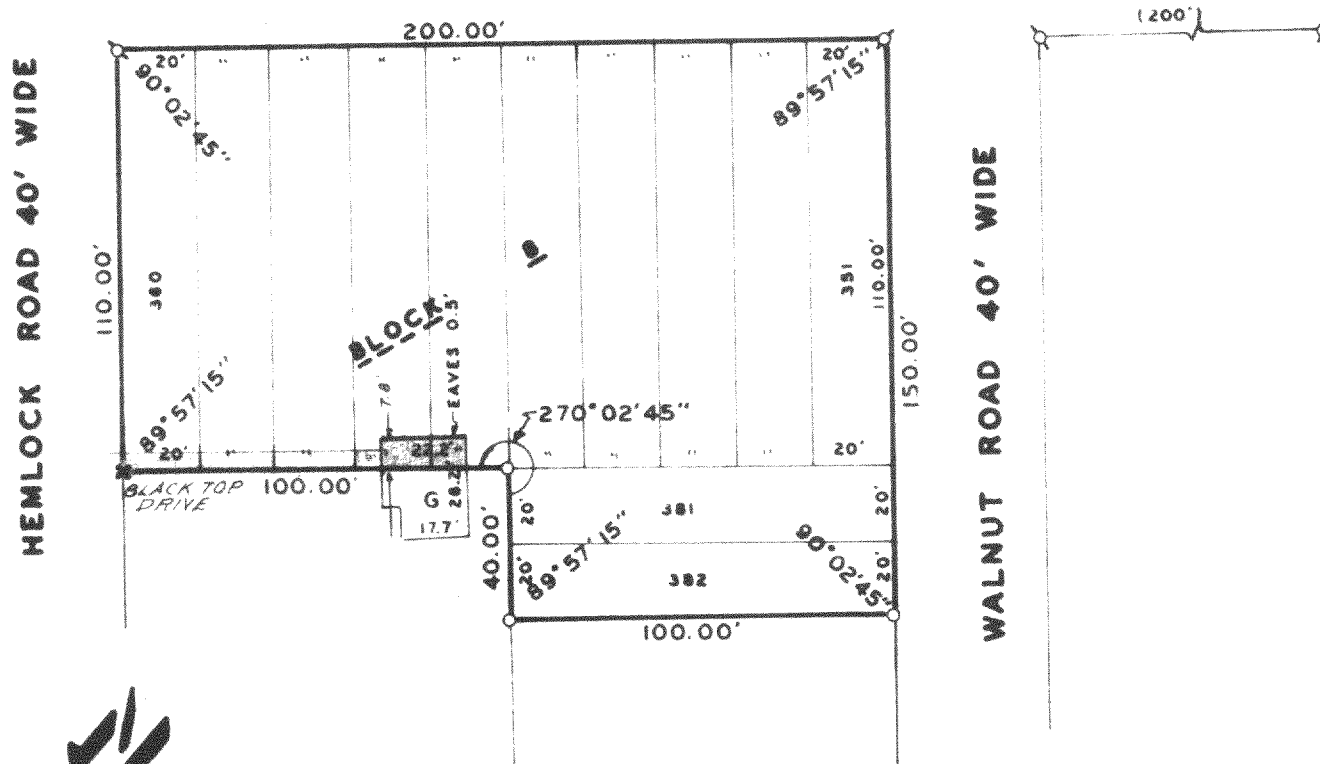

SCALE: 1" = 50'


OWNER: ROMAN BULKIEWICZ JR.

LEGEND

- Ø - IRON PIPE FOUND
- - 1" X 24" IRON PIPE SET
- () - AS RECORDED
- G - GARAGE
- * - RR SPIKE SET

PLAT OF SURVEY OF

LOTS 351-60 AND 381-82, BLOCK 3, OF THE
PELL LAKE SUBDIVISION, TOWN OF BLOOMFIELD,
WALWORTH COUNTY, WISCONSIN.

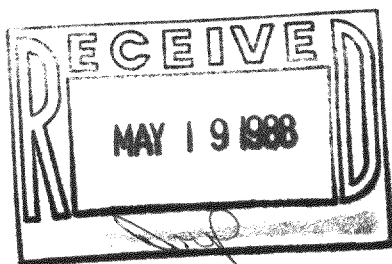

I, HAROLD H. KOLB, DO HEREBY CERTIFY
THAT I HAVE SURVEYED THE PROPERTY
HEREON DESCRIBED ACCORDING TO THE
OFFICIAL RECORDS AND THAT THE PLAT
HEREON IS A CORRECT REPRESENTATION
OF THE LOT LINES AND THE PRINCIPAL
LINES OF THE BUILDING THEREON, TO THE
BEST OF MY KNOWLEDGE AND BELIEF.
SURVEY NOT VALID UNLESS SURVEYOR'S
SIGNATURE IS IN RED.

HAROLD H. KOLB
WISCONSIN REGISTERED LAND SURVEYOR, S-197
DATE NOVEMBER 6, 1986
REVISED JANUARY 30, 1987
REVISED