

WALWORTH COUNTY
SURVEYING & MAPPING
LAKE GENEVA, WISCONSIN

ABANDONED RAILROAD R.O.W.
(S42°33'E 751.11')
750.86'

NE CORNER W1/2 SW1/4
SECTION 22, T1N, R18E

5.33 ACRES

WALNUT ROAD

BLOCK 173


PALM ROAD

EAGLE ROAD


PLAT OF SURVEY OF

LOTS 8172-8181, BLOCK 173 OF SECTION 5
OF PELL LAKE SUBDIVISION AND ALSO A
PARCEL OF LAND LOCATED IN THE SOUTHWEST
1/4 OF SECTION 22, T 1 N, R 18 E, WALWORTH
COUNTY, WISCONSIN.

BLOCK

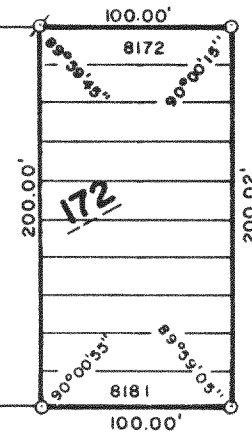

C.T.H. "H"

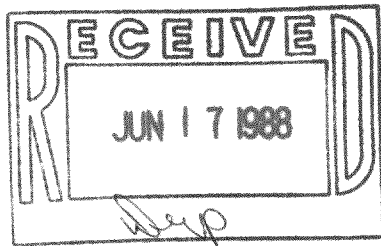

ORDERED BY: ED BORUCKI FOR JOSEPH C. LIS
6216 CANTERBURY
WILLOWBROOK, ILLINOIS
60514

SCALE: 1"=100'

⊕ - IRON PIPE FOUND
○ - IRON ROD PLACED
() - RECORDED AS

I, ROBERT M. BAERENWALD, DO HEREBY CERTIFY THAT I
HAVE SURVEYED THE PROPERTY HEREON DESCRIBED ACCORDING
TO THE OFFICIAL RECORDS AND THAT THE PLAT HEREON IS A
CORRECT REPRESENTATION OF THE PROPERTY LINES TO THE
BEST OF MY KNOWLEDGE AND BELIEF.

Robert M. Baerenwald
ROBERT M. BAERENWALD
WISCONSIN REGISTERED LAND SURVEYOR, S-1508

DATE *April 23, 1988* JOB NO. 1411

NOTE: THIS IS NOT A CERTIFIED COPY UNLESS SEALED.

MPL-1635, MB22-4

118-807