


DUNHAM SURVEYING, S.C.
SURVEYING & SUBDIVIDING
DELAVER, WISCONSIN 53115

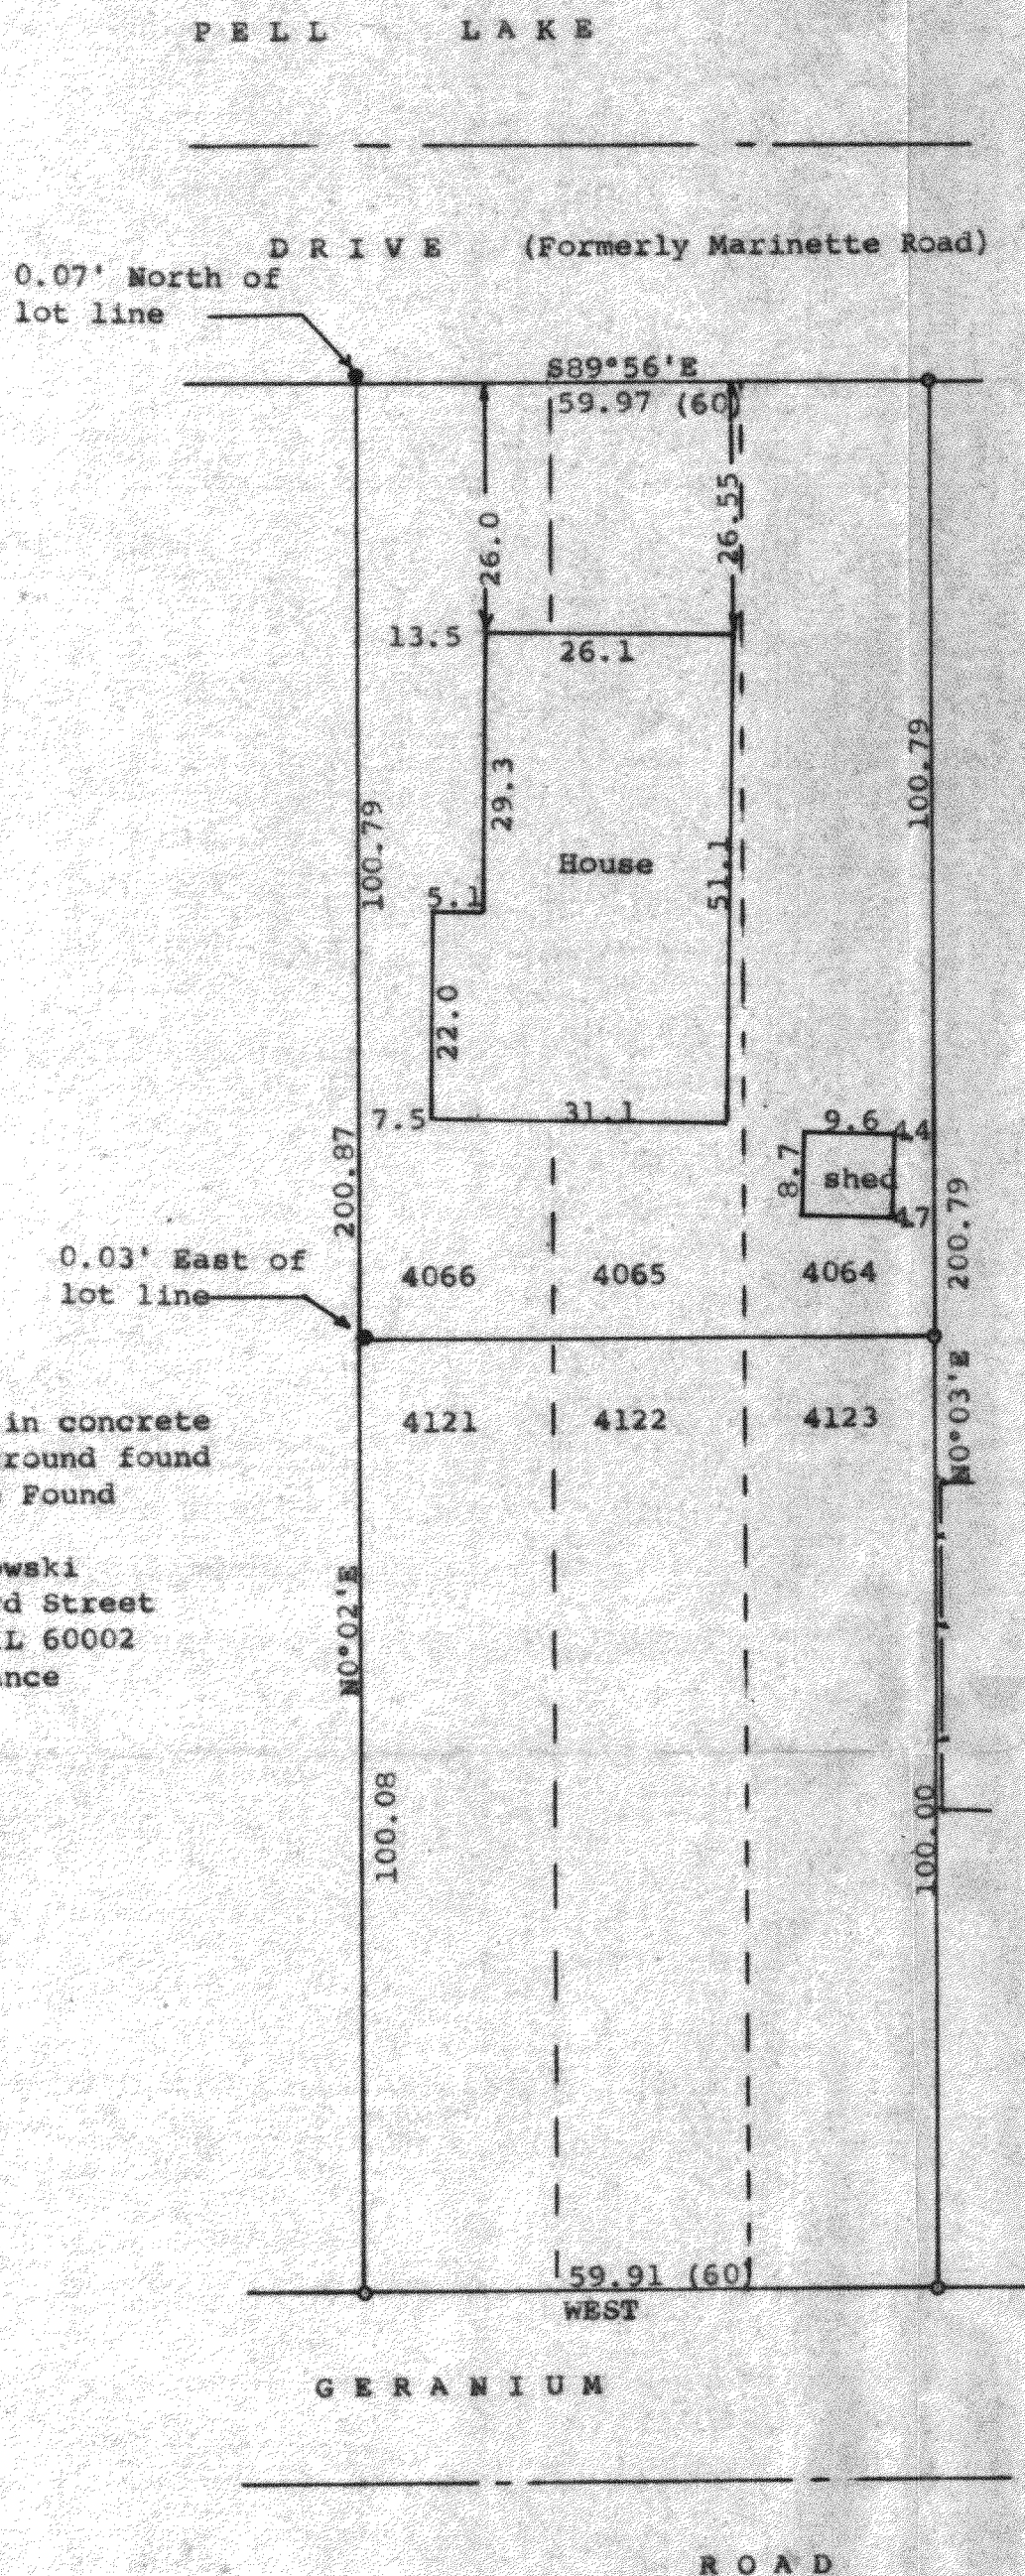

Scale - 1" = 20'

• = 1 1/2" Iron Pipe in concrete

.5' ± below ground found

o = 3/4" Iron Pipe Found

— = fence line

Survey ordered by: Barb Lepkowski
484 Orchard Street
Antioch, IL 60002

(0.00) = recorded distance


STATE OF WISCONSIN)
COUNTY OF WALWORTH)

I, George T. Dunham, Surveyor, certify that I have surveyed the property described as follows:

Lots 4064-4066 inclusive and Lots 4121-4123 inclusive in Block 82 of Section 3 of Pell Lake Subdivision located in Section 15, T 1 N, R 18 E, Walworth County, Wisconsin.

and that the plat shown hereon is a correct representation thereof and shows the size and location of the property, its exterior boundaries, the location of all visible structures and dimensions of all principal buildings thereon, boundary fences, apparent easements, roadways and visible encroachments, if any, and that I have surveyed the property hereon described, according to the official records, to the best of my knowledge and belief.

June 9, 1988

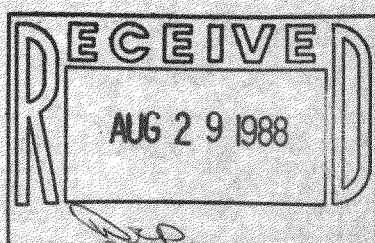

George T. Dunham
George T. Dunham, Surveyor

