



KOLB LAND CONSULTING, INC.
LAND SURVEYING • SUBDIVIDING • LAND PLANNING

929 WILLIAMS STREET LAKE GENEVA, WISCONSIN 53147 414-248-3697

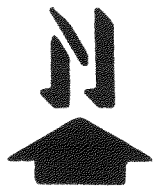

SCALE: 1" = 100'

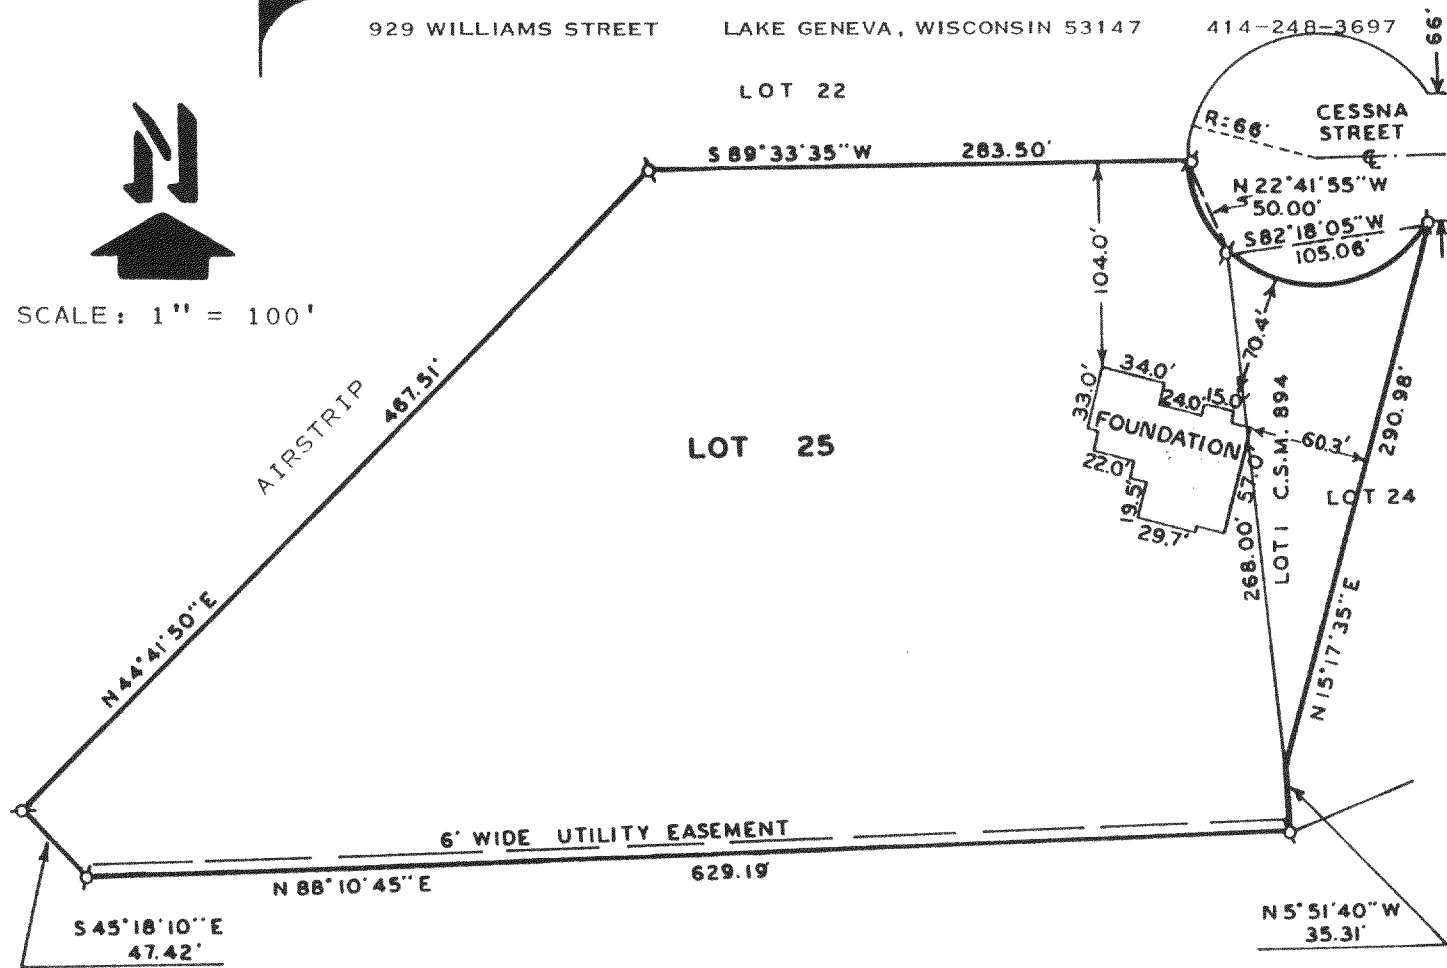

PLAT OF SURVEY OF

LOT 25, FIRST ADDITION TO LAKE GENEVA AIRE
ESTATES AND LOT 1, CERTIFIED SURVEY MAP NO.
894, LOCATED IN THE SOUTHEAST 1/4 OF SECTION
4, T1N, R18E, TOWN OF BLOOMFIELD, WALWORTH
COUNTY, WISCONSIN.


LEGEND

Ø - IRON PIPE
FOUND

NOTE: BEARINGS AS SHOWN ON RECORDED SUB-
DIVISION PLAT.

ORDERED BY: MARSHA WARNER % THE TAGGART AGENCY
1048 NORTH HWY. "H"
LAKE GENEVA, WI. 53147

10-27-88 : JOHN VOGEL
307 N. GOSSELL ROAD
WAUCONDA, IL. 60084

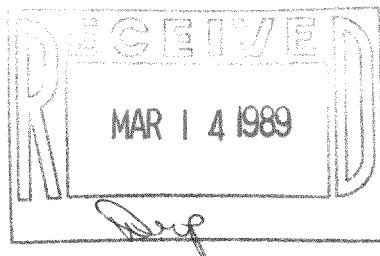

I, HAROLD H. KOLB, DO HEREBY CERTIFY
THAT I HAVE SURVEYED THE PROPERTY
HEREON DESCRIBED ACCORDING TO THE
OFFICIAL RECORDS AND THAT THE PLAT
HEREON IS A CORRECT REPRESENTATION
OF THE LOT LINES TO THE BEST OF MY
KNOWLEDGE AND BELIEF.
SURVEY NOT VALID UNLESS SURVEYOR'S
SIGNATURE IS IN RED.

HAROLD H. KOLB
WISCONSIN REGISTERED LAND SURVEYOR, S-187
DATE SEPTEMBER 9, 1988
REVISED OCTOBER 27, 1988
REVISED _____

118-857