


Plat of Survey
FOR
KEITH JOHNSON REALTY

SITUATED ON VIOLET ROAD, IN THE TOWN OF BLOOMFIELD, WISCONSIN.
LOT 16 IN BLOCK 4 IN ROSE NIPPERSINK GARDENS, BEING A SUBDIVISION OF A PART OF THE
SE 1/4 AND A PART OF THE SW 1/4 OF THE SE FRACTIONAL 1/4 OF SECTION 24, T 1 N, R 18 E,
IN THE TOWN OF BLOOMFIELD, WALWORTH COUNTY, WISCONSIN.

APRIL 7, 1989


ANDREW MC MANUS

SURVEY NO. 152863-S

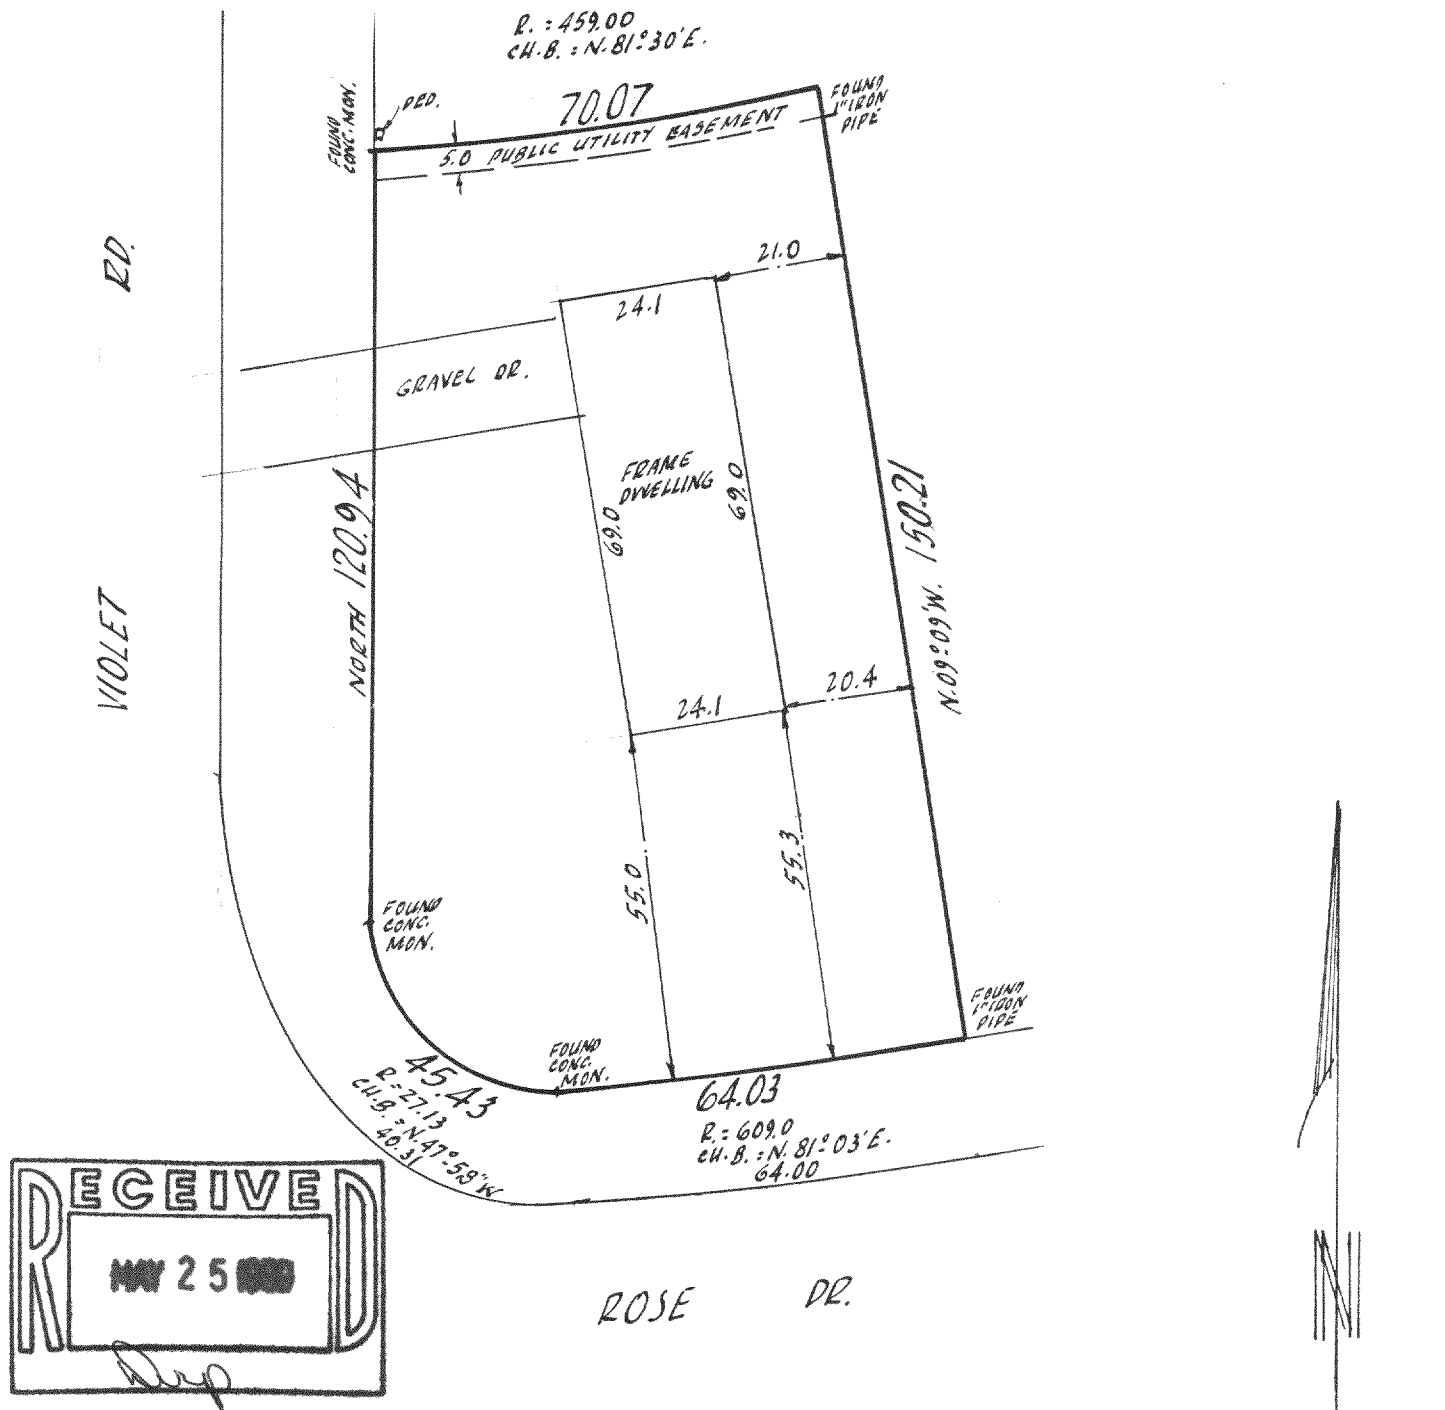

I Certify that I have surveyed the above described property (Property), and the above map is a true representation thereof and shows the size and location of the Property, its exterior boundaries, the location and dimensions of all visible structures thereon, boundary fences, apparent easements and roadways and visible encroachments, if any.
This survey is made for the exclusive use of the present owners of the Property, and also those who purchase, mortgage, or guarantee the title thereto, within one (1) year from date hereof.

Kenneth E. Berke
SURVEYOR

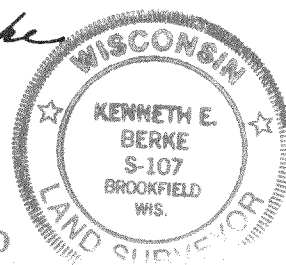

THIS IS ORIGINAL
PRINT ONLY IF
SEAL IS IMPRINTED
IN RED

national survey & engineering
3470 north 127th street brookfield, wisconsin 53008
p. o. box 53008-0444 phone 414/781-1000

118-863