



PLAT OF SURVEY
OF

LOTS 4047 THRU 4051 IN BLOCK 81 OF PELL LAKE SUBDIVISION, TOWN OF BLOOMFIELD, WALWORTH COUNTY, WISCONSIN.

FOR: GRUNNER SCALE 1" = 30' ♂ = IRON PIPE STAKE FOUND.

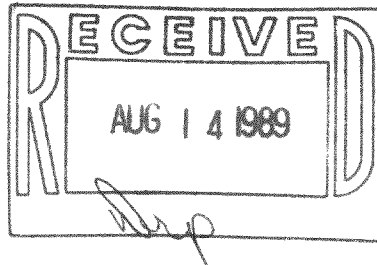

PELL LAKE DRIVE

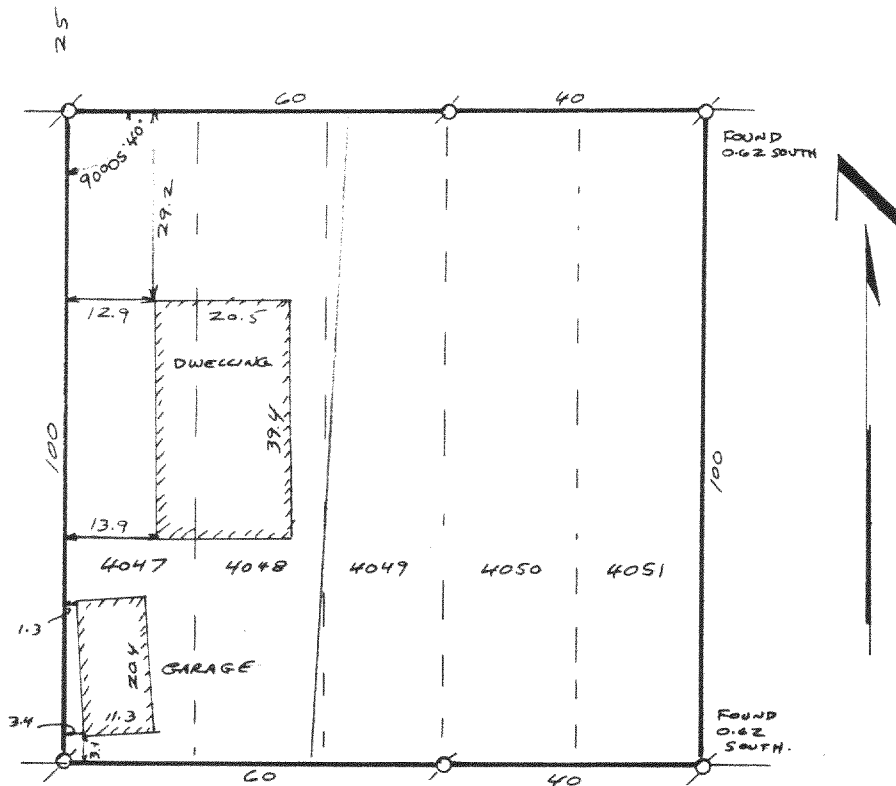

I have surveyed the above-described property, and the map hereon is a true representation thereof and shows the size and location of the property, its exterior boundaries, the location and dimensions of all visible structures thereon, fences, apparent easements and roadways and visible encroachments, if any.

This survey is made for the exclusive use of the present owners of the property, and also those who purchase, mortgage, or guarantee the title thereto, within one year from date hereof.

Dated at Burlington, this 26th day, of JUNE, 1989

John F. Degen

John F. Degen, Land Surveyor S 242
589 N. Pine St. Burlington, WI 53105

118-877

MPL-847

118-877