

PLAT OF SURVEY
OF



LOTS 4274-4276, INCLUSIVE, BLOCK 85 OF SECTION 3 OF PELL LAKE SUBDIVISION, LOCATED IN T. 1 N., R. 18 E., OF THE 4TH P. M., TOWNSHIP OF BLOOMFIELD, WALWORTH COUNTY, WISCONSIN.

FOR: ANDERSON

o = IRON PIPE STAKE SET.

o = SURVEY MARKER FOUND OF TYPE NOTED ON PLAT.

SCALE: 1" = 20'

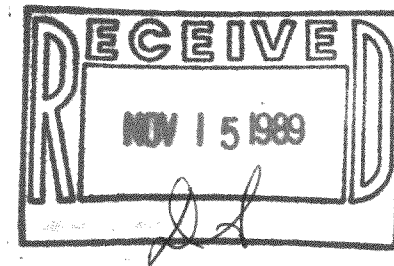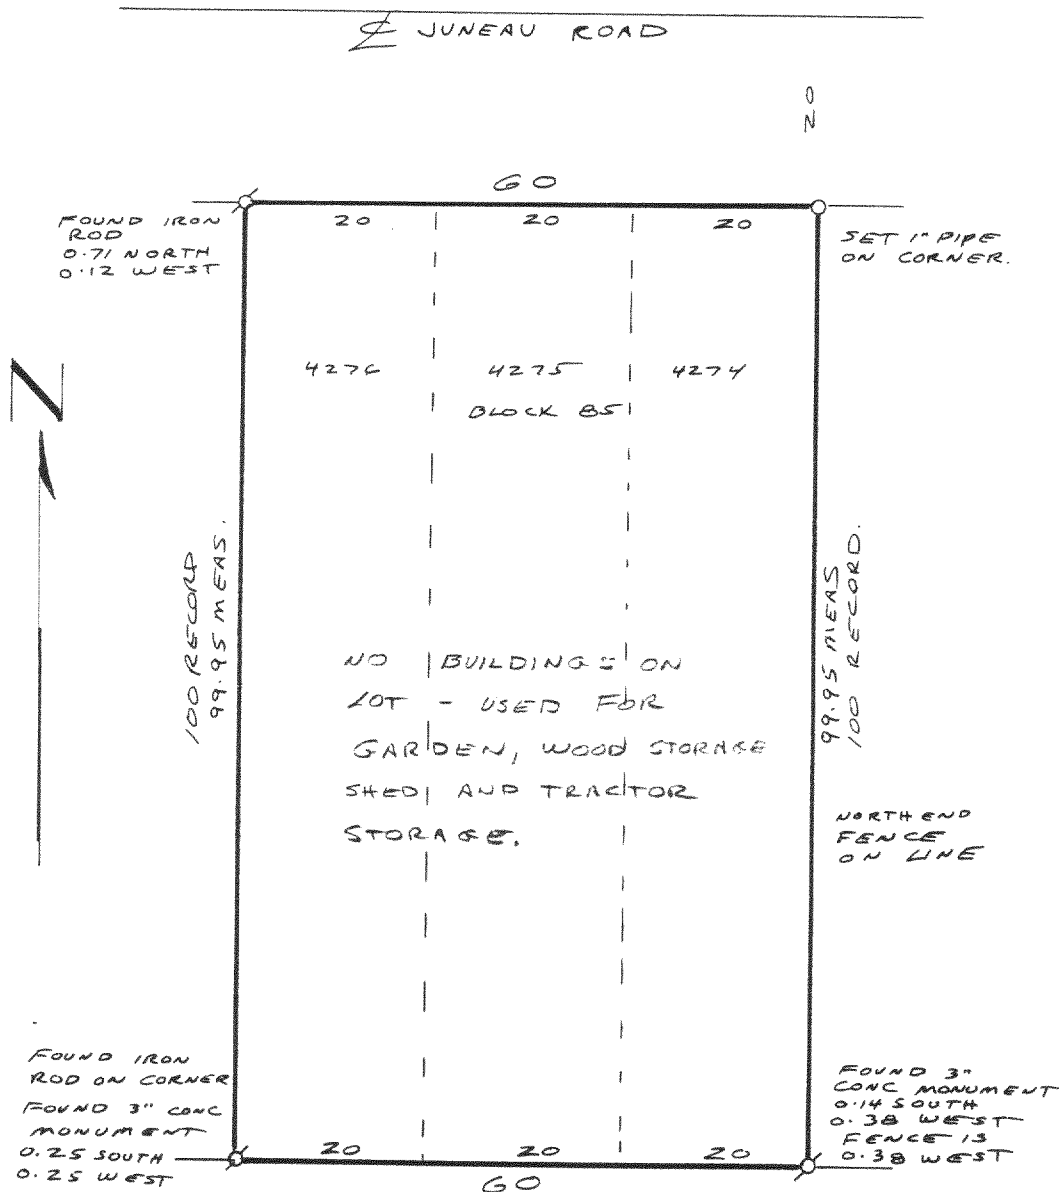

I have surveyed the above-described property, and the map hereon is a true and correct representation thereof and shows the size and location of the property, its exterior boundaries, location and dimensions of all visible structures thereon, fences, apparent easements and rights-of-way and visible encroachments, if any.

This survey is made for the exclusive use of the present owners of the property, and also those who purchase, mortgage, or guarantee the title thereto, within one year from date hereof.

Dated at Burlington, this 6th day, of OCT, 19 89

John F. Degen
John F. Degen, Land Surveyor S 242
589 N. Pine St. Burlington, WI 53105

MPL - 905