
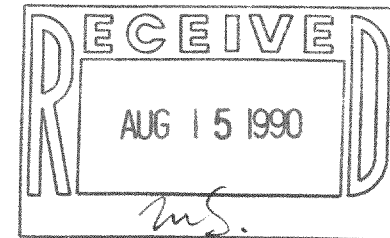


PLAT OF SURVEY
OF

LOTS 3138 THRU 3144, BLOCK 49 OF SECTION 2 OF PELL LAKE, A SUBDIVISION LOCATED IN THE NORTHEAST 1/4 OF SECTION 22,
T. 1 N., R. 18 E. OF THE 4TH P.M., TOWNSHIP OF BLOOMFIELD, COUNTY OF WALWORTH, STATE OF WISCONSIN.

FOR: PERKINS SCALE 1" = 40' σ = IRON STAKE OF TYPE NOTED ON PLAT. BEARING DATUM IS THAT OF RECORDED PLAT.

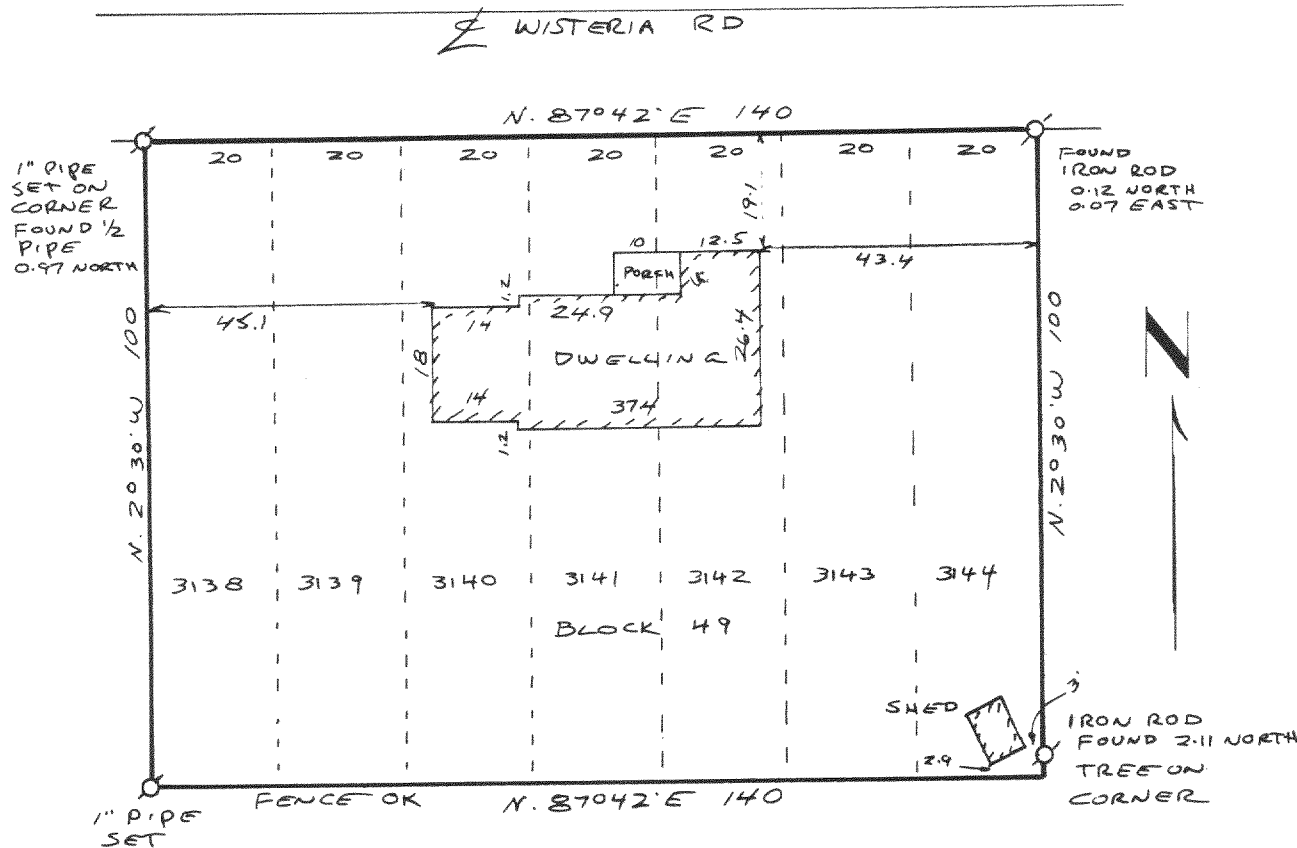

I have surveyed the above-described property, and the map hereon is a true representation thereof and shows the size and location of the property, its exterior boundaries, the location and dimensions of all visible structures thereon, fences, apparent easements and roadways and visible encroachments, if any.

This survey is made for the exclusive use of the present owners of the property, and also those who purchase, mortgage, or guarantee the title thereto, within one year from date hereof,

Dated at Burlington, this 15th day of MAY, 1990

John F. Degen
John F. Degen, Land Surveyor S 242
589 N. Pine St. Burlington, WI 53105

TAX# MPL-655

118-913

16-C-2-91