
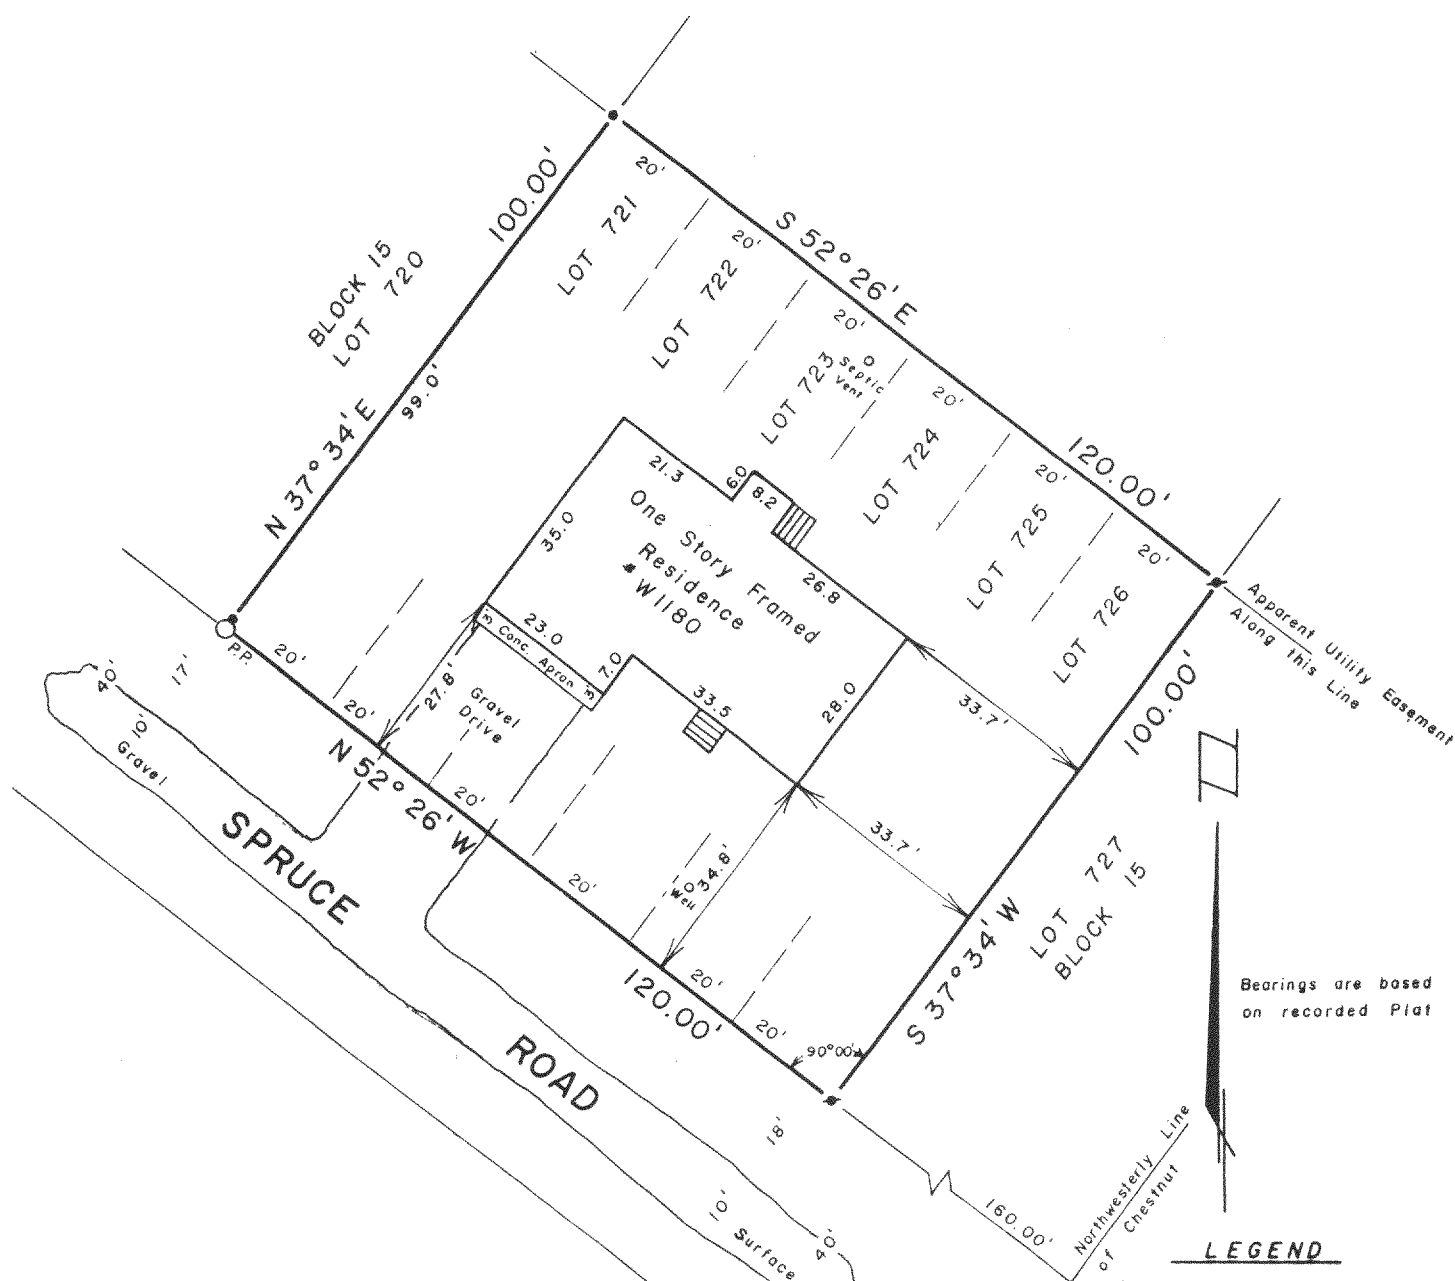


**Baxter
&
Woodman**
of Wisconsin

326 NORTH PINE STREET / BURLINGTON, WI 53105 / 414/763-7834
FAX / 414/763-2509

PLAT OF SURVEY
FOR
WALTER GONSIOR

Lots 721, 722, 723, 724, 725, 726, Block 15, Pell Lake Subdivision, Section 1,
Town 1 North, Range 18 East, Town of Bloomfield, Walworth County, Wisconsin.

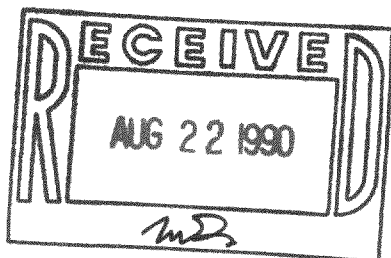

"I hereby certify that I have surveyed the above described property and that the above map is a true representation thereof and shows the size and location of the property, its exterior boundaries, the location of all visible structures and dimensions of all principal buildings thereon, boundary fences, apparent easements, roadways and visible encroachments, if any.

"This survey is made for the use of the present owners of the property, and also those who purchase, mortgage, or guarantee the title thereto within one year from date hereof."

NO MONUMENTATION HAS BEEN WAIVED IN ACCORDANCE
WITH A-E 5.01(b) OF THE WISCONSIN ADMINISTRATIVE
CODE.

TAX # MPL-160

Ralph L. Anderson

WISCONSIN REGISTERED LAND SURVEYOR #1327

8/16/90

DATE

FIELD WORK BY rla & bjz DRAWN BY bjz

SCALE - 1" = 30'

118-918

90206

JOB NUMBER

THIS IS A ORIGINAL POINT ONLY
IF SEAL IS IMPRINTED IN RED.



- LEGEND**
- + CHISEL CUT IN CONCRETE
 - o PK NAIL
 - FOUND IRON PIPE - 1"
 - FOUND IRON PIPE - 1 1/2"
 - o SET IRON PIPE -
 - FOUND BRASS CAPPED MONUMENT
 - ⊕ FOUND CONCRETE MONUMENT
 - FENCE
 - () RECORDED AS
 - EXISTING GROUND ELEVATION