

PLAT OF SURVEY
OF



LOTS 6 & 7, BLOCK 3, OF PART ONE OF THE FIRST ADDITION TO JEFFERSON ISLAND
SUBDIVISION, BEING PART OF THE SOUTHEAST 1/4 OF SECTION 13, T. 1 N.,
R. 18 E. OF THE 4TH P.M., TOWN OF BLOOMFIELD, WALWORTH COUNTY, WISCONSIN

FOR: REALTY WORLD JOHNSON

SCALE 1" = 30'

o = IRON PIPE STAKE FOUND.

BEARING DATUM IS THAT OF RECORDED PLAT.

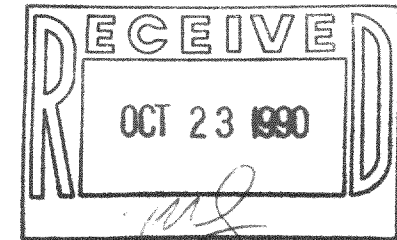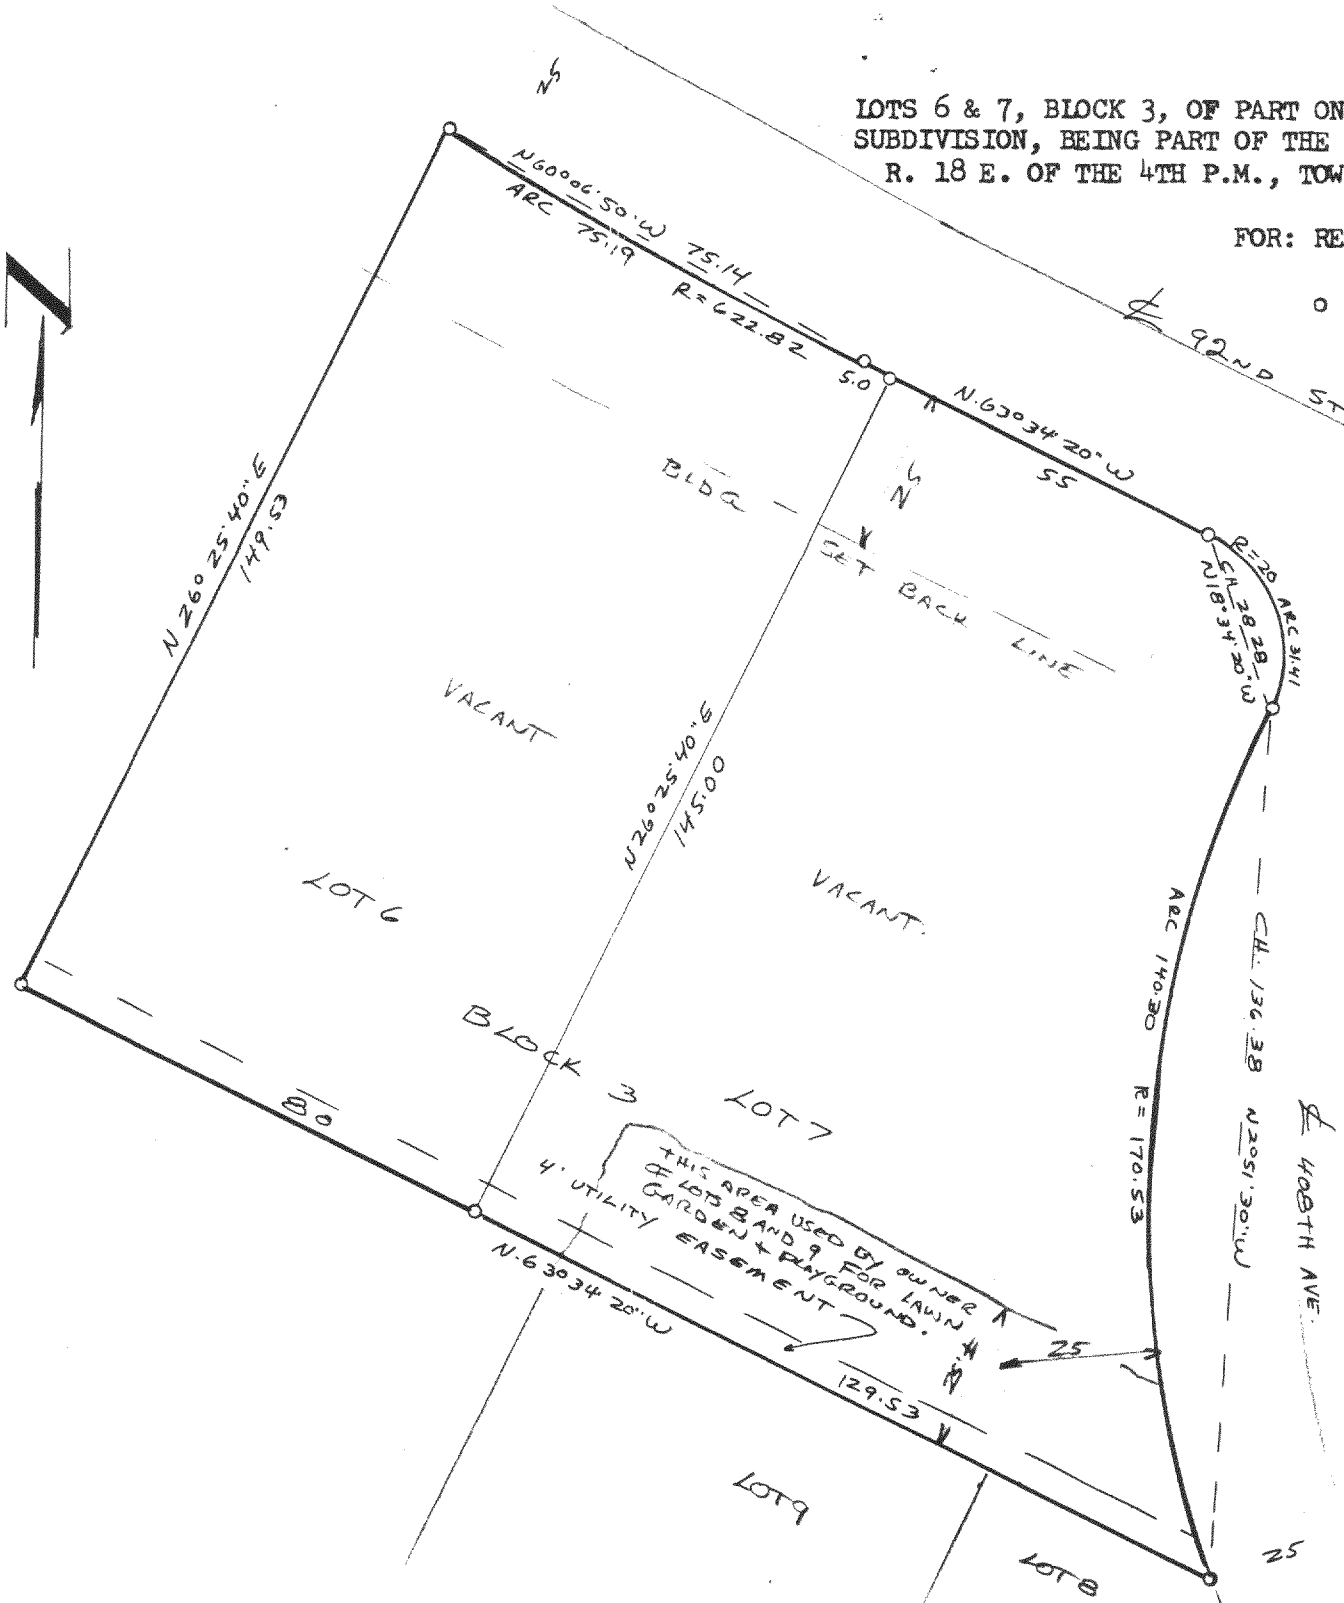

I have surveyed the above-described property, and the map hereon is a true representation thereof and shows the size and location of the property, its exterior boundaries, the location and dimensions of all visible structures thereon, fences, apparent easements and roadways and visible encroachments, if any.

This survey is made for the exclusive use of the present owners of the property, and also those who purchase, mortgage, or guarantee the title thereto, within one year from date hereof,

Dated at Burlington, this 6th day, of SEPT, 19 90

John F. Degen
John F. Degen, Land Surveyor 5242
589 N. Pine St. Burlington, WI 53105

TAX KEY #3 MJ15 00022
MJ15 00023

118-921

10-0-3 #7