


WALWORTH COUNTY
SURVEYING & MAPPING
 727 HENRY STREET
 LAKE GENEVA, WISCONSIN
 414-248-0505



GERANIUM ROAD

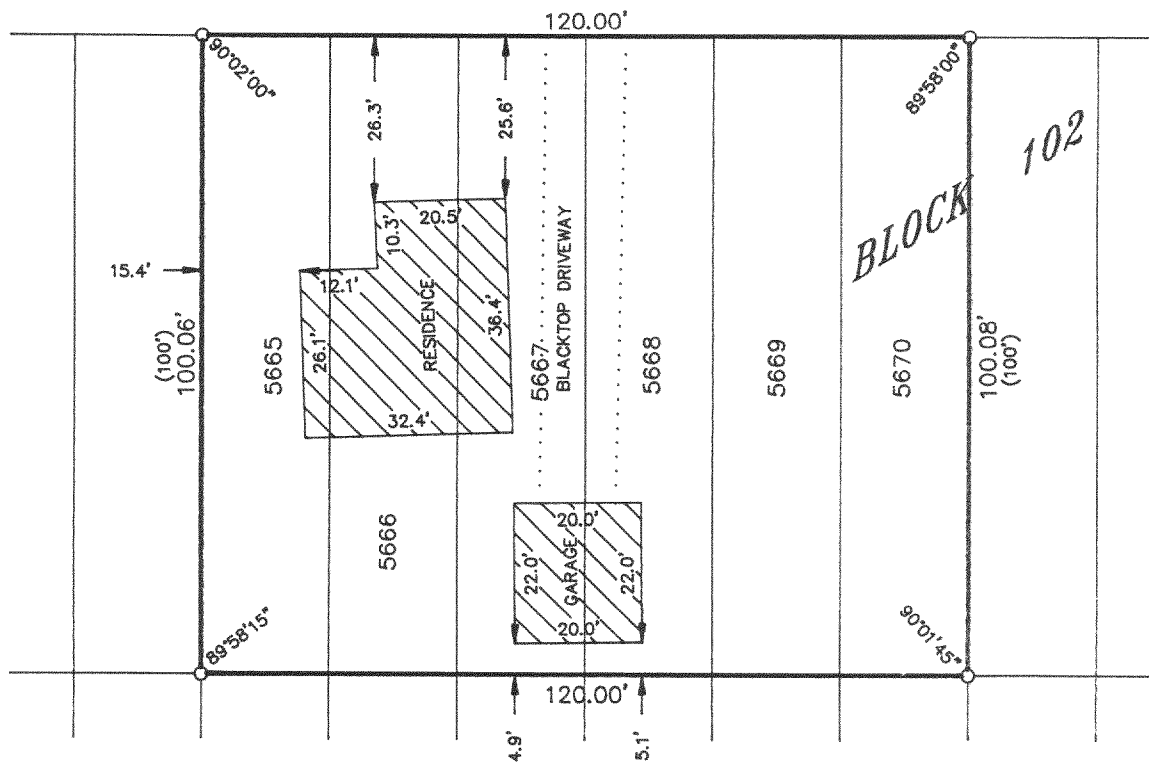

PLAT OF SURVEY OF

LOTS 5665-5670, BLOCK 102 OF SECTION 3 OF PELL LAKE SUBDIVISION,
 LOCATED IN T 1 N, R 18 E, WALWORTH COUNTY, WISCONSIN.

ORDERED BY: JERRY ONUSZKO
 BOX 340
 PELL LAKE, WISCONSIN

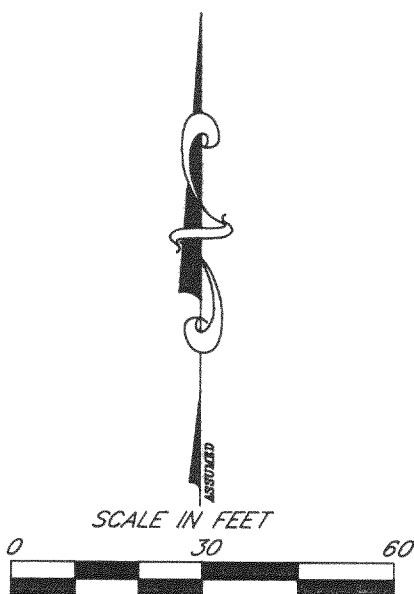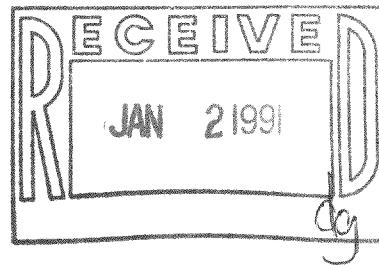

LEGEND
 S-IRON PIPE FOUND
 R-IRON ROD FOUND
 C-CONCRETE MONUMENT FOUND
 O-IRON PIPE PLACED
 (-)RECORDED AS

I HEREBY CERTIFY THAT I HAVE SURVEYED THE ABOVE DESCRIBED
 PROPERTY AND THAT THE ABOVE MAP IS A TRUE REPRESENTATION
 THEREOF AND SHOWS THE SIZE AND LOCATION OF THE PROPERTY,
 ITS EXTERIOR BOUNDARIES, THE LOCATION OF ALL VISIBLE STRUCTURES
 AND DIMENSIONS OF ALL PRINCIPAL BUILDINGS THEREON, BOUNDARY
 FENCES, APPARENT EASEMENTS, ROADWAYS AND VISIBLE ENCROACH-
 MENTS, IF ANY, TO THE BEST OF MY KNOWLEDGE AND BELIEF.

THIS SURVEY IS MADE FOR THE USE OF THE PRESENT OWNERS OF
 THE PROPERTY AND ALSO THOSE WHO PURCHASE, MORTGAGE OR
 GUARANTEE THE TITLE THERETO WITHIN ONE (1) YEAR FROM DATE
 HEREOF.

Robert M. Baerenwald
 ROBERT M. BAERENWALD
 WISCONSIN REGISTERED LAND SURVEYOR, S-1508

DATE *March 15, 1990*
 JOB NO. 2405

NOTE: THIS IS NOT A CERTIFIED COPY UNLESS SEALED.

Survey# 118-928

TAX KEY# MPL 01234