


The map shows a residential property (Lot 15) situated between four other lots (14, 16, 17, and 18). The property is bounded by a 'ROADWAY' to the north and a 'ROADWAY' to the south. A 'DRIVEWAY' is located on the right side of the property. The 'RESIDENCE' is a large rectangular structure with a complex footprint, including a central rectangular area and several smaller rectangular extensions. Dimensions are provided for all boundary lines and internal divisions. The map also shows a 'ROADWAY' at the top and bottom, and a 'DRIVEWAY' on the right side. The 'RESIDENCE' is a large rectangular structure with a complex footprint, including a central rectangular area and several smaller rectangular extensions. Dimensions are provided for all boundary lines and internal divisions.

LOTS 15 AND 16 OF SHINER'S FOURTH ADDITION TO
WINNIPERSINK PARK, LOCATED IN SECTION 24, T 1 N,
R 18 E, WALWORTH COUNTY, WISCONSIN.

ORDERED BY: JACOBSEN-SORKIN
188 WEST RANDOLPH
CHICAGO, ILLINOIS 60601

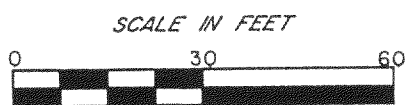

- I HEREBY CERTIFY THAT I HAVE SURVEYED THE ABOVE DESCRIBED PROPERTY AND THAT
 THE ABOVE MAP IS A TRUE REPRESENTATION THEREOF AND SHOWS THE SIZE AND
 LOCATION OF THE PROPERTY, ITS EXTERIOR BOUNDARIES, THE LOCATION OF ALL VISIBLE
 STRUCTURES AND DIMENSIONS OF ALL PRINCIPAL BUILDINGS THEREON, BOUNDARY FENCES,
 APPARENT EASEMENTS AND ROADWAYS AND VISIBLE ENCROACHMENTS, IF ANY, TO THE
 BEST OF MY KNOWLEDGE AND BELIEF.

THIS SURVEY IS MADE FOR THE USE OF THE PRESENT OWNERS OF THE PROPERTY AND ALSO THOSE WHO PURCHASE, MORTGAGE OR GUARANTEE THE TITLE THERETO WITHIN ONE (1) YEAR FROM DATE HEREOF.

Robert M. Baerenwald
ROBERT M. BAERENWALD
WISCONSIN REGISTERED LAND SURVEYOR S-1508

DATE JUN. 23, 1990 JOB NO. 2332

NOTE: THIS IS NOT A CERTIFIED COPY UNLESS SEALED

Survey # 118-948

TAX KEY # MNPS 400055