


WALWORTH COUNTY
SURVEYING & MAPPING
LAKE GENEVA, WISCONSIN


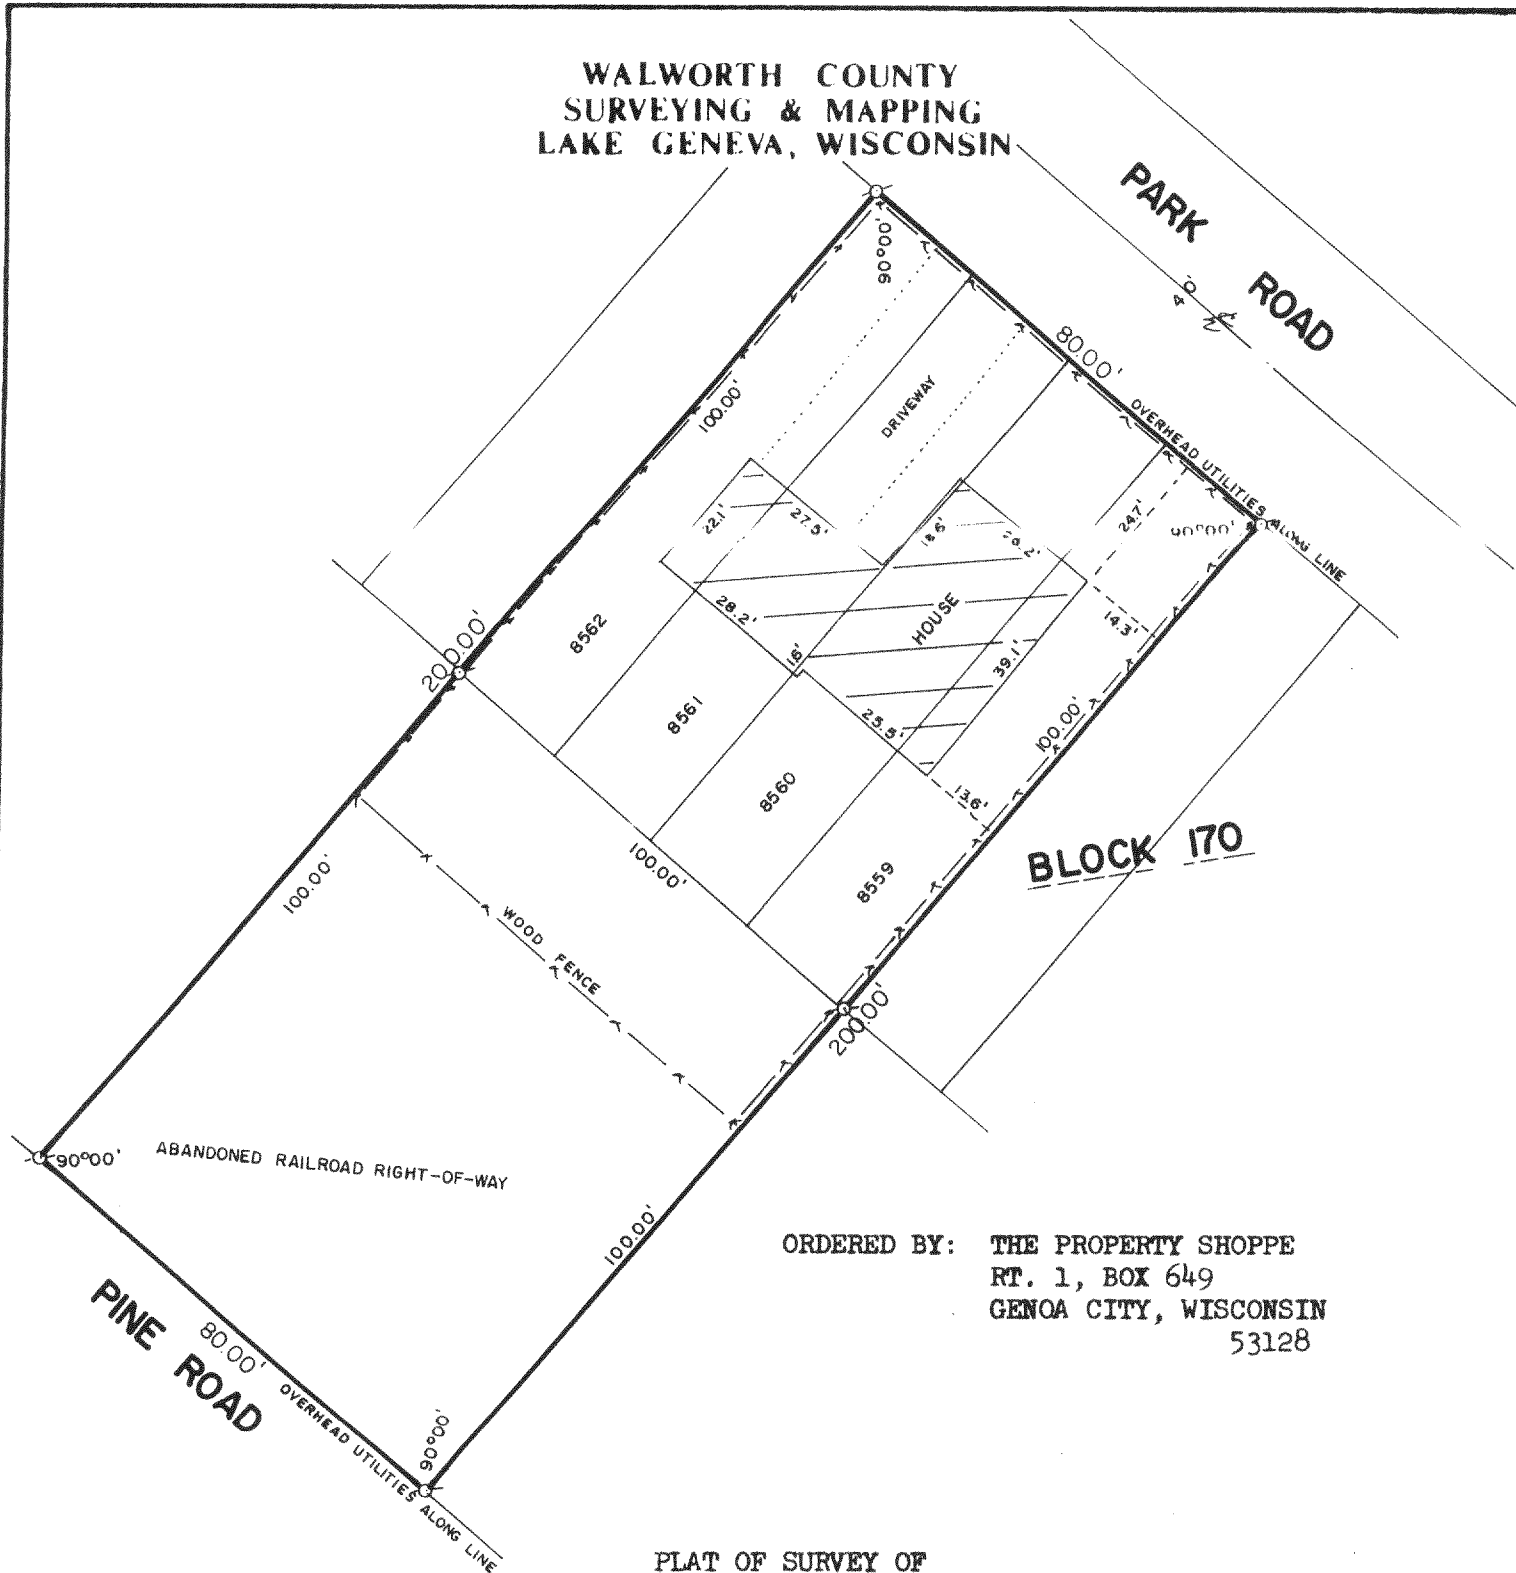


ORDERED BY: THE PROPERTY SHOPPE
RT. 1, BOX 649
GENOA CITY, WISCONSIN
53128

PLAT OF SURVEY OF

LOTS 8559-8562, BLOCK 170 OF PELL LAKE SUBDIVISION, LOCATED IN T 1 N, R 18 E,
WALWORTH COUNTY, WISCONSIN.

ALSO, THAT PART OF THE SOUTHWEST QUARTER OF THE NORTHWEST QUARTER OF SECTION 22,
T 1 N, R 18 E, BOUNDED AS FOLLOWS: ON THE NORTHWEST BY THE SOUTHWESTERLY EXTENSION
OF THE NORTHWESTERLY LINE OF LOT 8562 IN BLOCK 170 IN PELL LAKE; ON THE NORTHEAST
BY THE SOUTHWESTERLY LINE OF SAID BLOCK 170; ON THE SOUTHEAST BY THE SOUTHWESTERLY
EXTENSION OF THE SOUTHEASTERLY LINE OF LOT 8559 IN SAID BLOCK 170; AND ON THE SOUTH-
WEST BY THE NORTHEASTERLY LINE OF PINE ROAD.

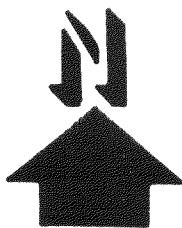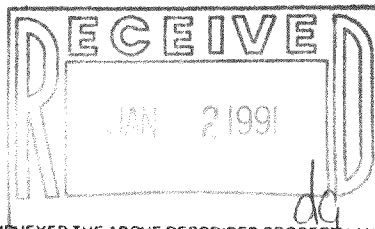

SCALE: 1"=30'

Ø - IRON PIPE FOUND

I HEREBY CERTIFY THAT I HAVE SURVEYED THE ABOVE DESCRIBED PROPERTY AND THAT THE ABOVE
MAP IS A TRUE REPRESENTATION THEREOF AND SHOWS THE SIZE AND LOCATION OF THE PROPERTY,
ITS EXTERIOR BOUNDARIES, THE LOCATION OF ALL VISIBLE STRUCTURES AND DIMENSIONS OF ALL
PRINCIPAL BUILDINGS THEREON, BOUNDARY FENCES, APPARENT EASEMENTS AND ROADWAYS AND
VISIBLE ENCROACHMENTS, IF ANY.

THIS SURVEY IS MADE FOR THE EXCLUSIVE USE OF THE PRESENT OWNERS OF THE PROPERTY, AND
ALSO THOSE WHO PURCHASE, MORTGAGE, OR GUARANTEE THE TITLE THERETO WITHIN ONE (1) YEAR
FROM DATE HEREOF.

Robert M. Baerenwald
ROBERT M. BAERENWALD
WISCONSIN REGISTERED LAND SURVEYOR, S-1508

DATE *July 31, 1989* JOB NO. 0585

NOTE: THIS IS NOT A CERTIFIED COPY UNLESS SEALED.

Survey # 118-950

TAX KEY # MPL 817 R