


WALWORTH COUNTY
SURVEYING & MAPPING
LAKE GENEVA, WISCONSIN
414-248-0505

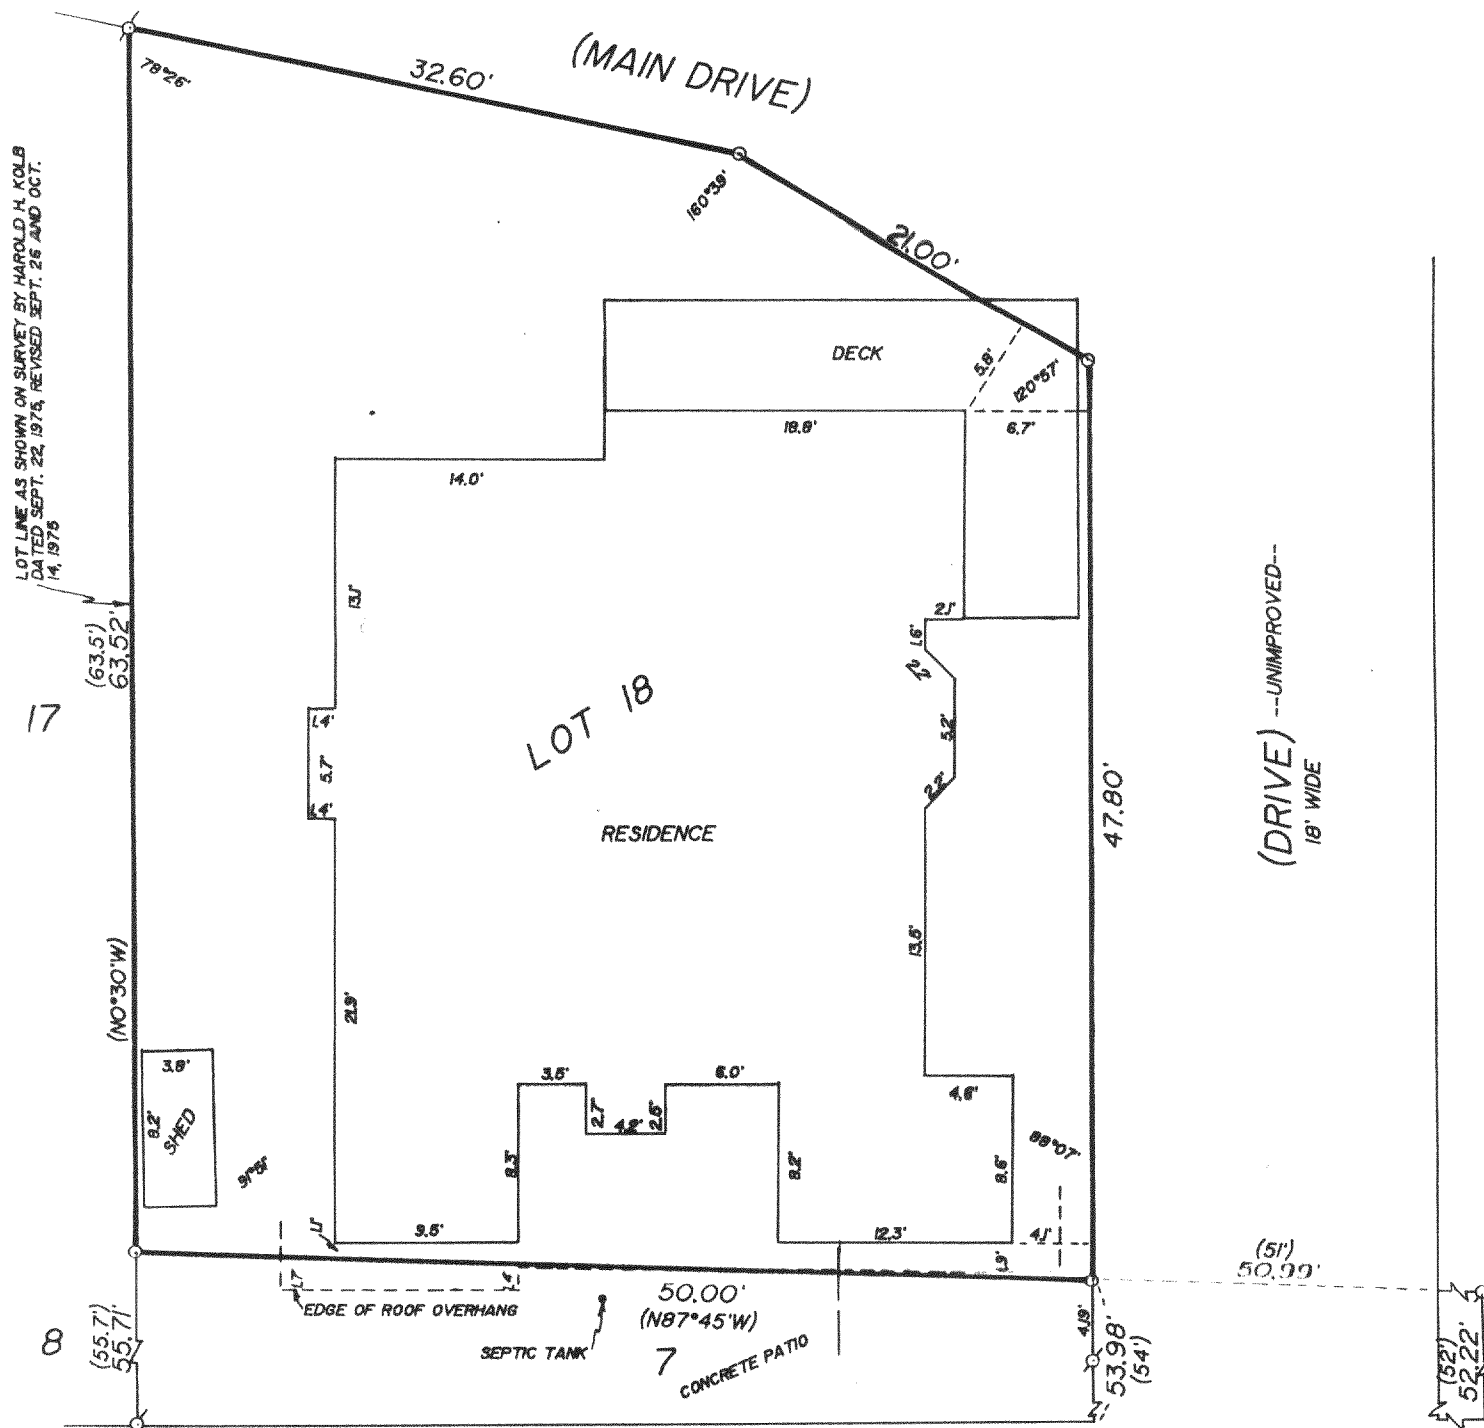

PLAT OF SURVEY OF

LOT 18 OF SHINNER'S 3RD ADDITION TO NIPPERSINK
PARK, LOCATED IN SECTION 24, T 1 N, R 18 E,
WALWORTH COUNTY, WISCONSIN.

ORDERED BY: STUMPF REALTY
2808 LAKESHORE WAY
TWIN LAKES, WISCONSIN 53181

I HEREBY CERTIFY THAT I HAVE SURVEYED THE ABOVE DESCRIBED PROPERTY AND THAT
THE ABOVE MAP IS A TRUE REPRESENTATION THEREOF AND SHOWS THE SIZE AND
LOCATION OF THE PROPERTY, ITS EXTERIOR BOUNDARIES, THE LOCATION OF ALL VISIBLE
STRUCTURES AND DIMENSIONS OF ALL PRINCIPAL BUILDINGS THEREON, BOUNDARY LINES,
APPARENT EASEMENTS AND ROADWAYS AND VISIBLE ENCROACHMENTS, IF ANY, TO THE
BEST OF MY KNOWLEDGE AND BELIEF.


THIS SURVEY IS MADE FOR THE USE OF THE PRESENT OWNERS OF THE PROPERTY AND
ALSO THOSE WHO PURCHASE, MORTGAGE OR GUARANTEE THE TITLE THEREIN WITHIN
ONE (1) YEAR FROM DATE HEREOF.

Robert M. Bannwald
ROBERT M. BANNWALD
WISCONSIN REGISTERED LAND SURVEYOR S-1508

DATE Oct. 3, 1989 JOB NO. 2175

NOTE: THIS IS NOT A CERTIFIED COPY UNLESS SEALED

♂-IRON PIPE FOUND
○-IRON PIPE PLACED
()-RECORDED AS

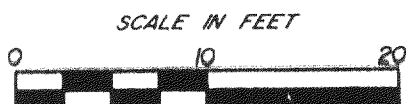

118-955

MNPS 300040