
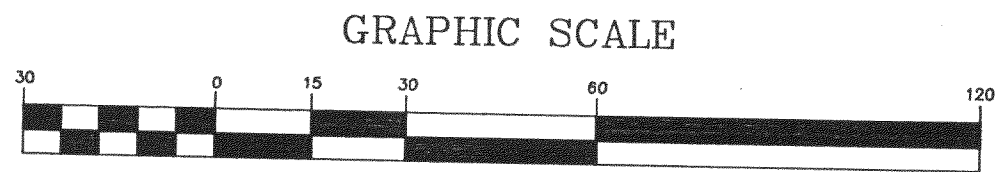
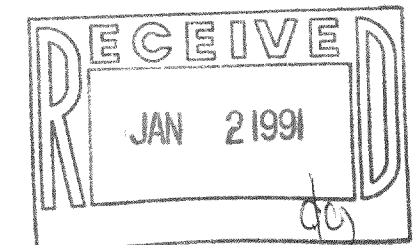


WALWORTH COUNTY
SURVEYING & MAPPING
727 HENRY STREET
LAKE GENEVA, WISCONSIN
414-248-0505

EASTWOOD ROAD

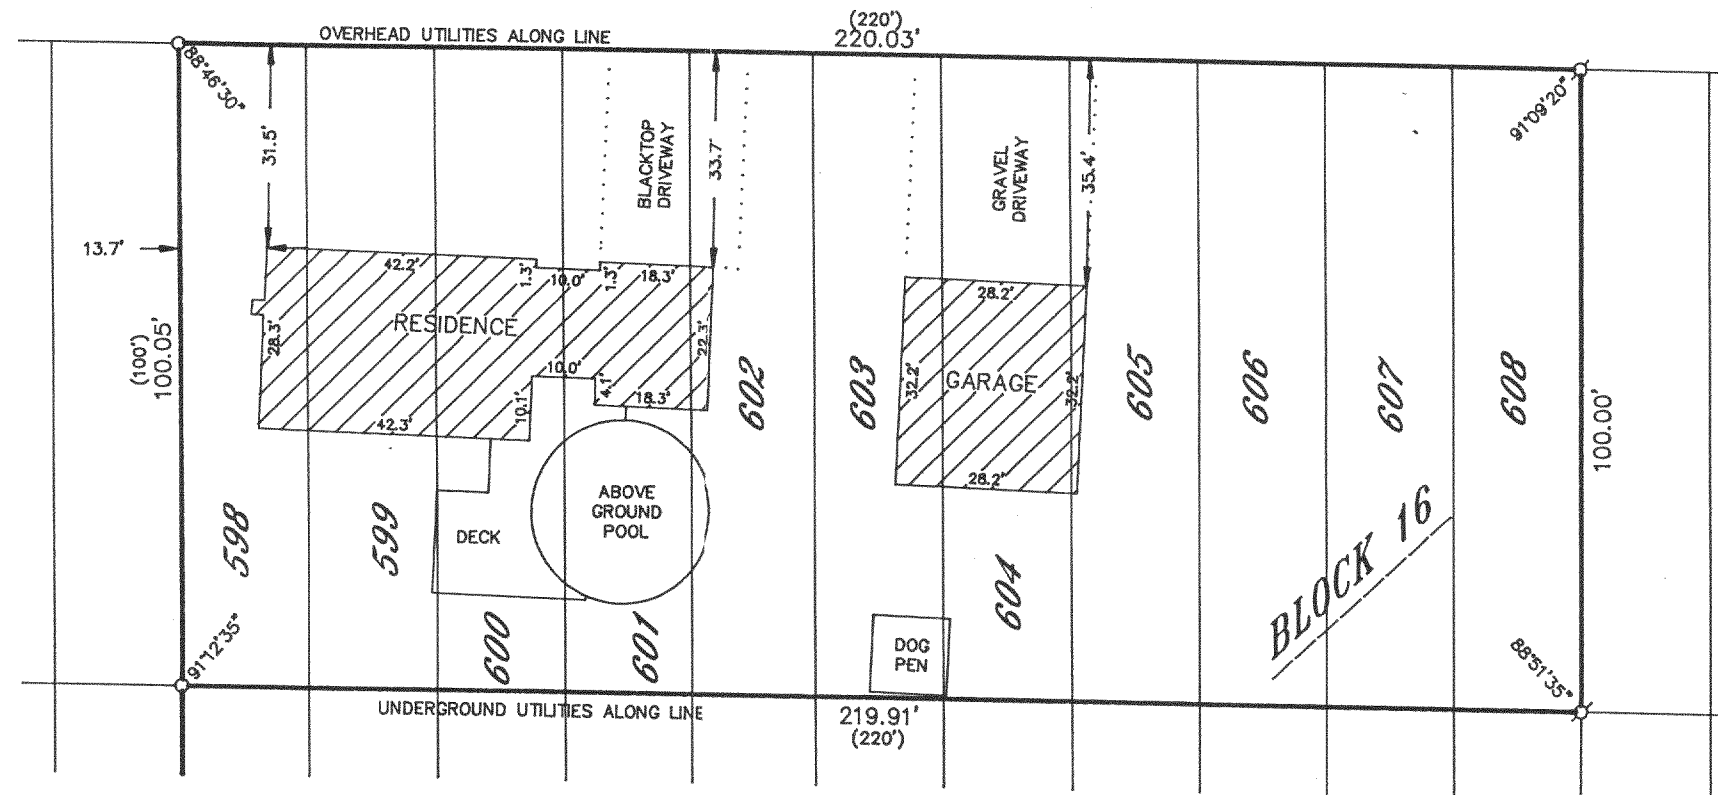

GRAPHIC SCALE

(IN FEET)
1 inch = 30 ft.

LEGEND

- ⊙ - IRON PIPE FOUND
- - IRON PIPE PLACED
- () - RECORDED AS

PLAT OF SURVEY OF

LOTS 598-608, BLOCK 16 OF PELL LAKE HIGHLANDS,
LOCATED IN SECTION 16, T 1 N, R 18 E, WALWORTH
COUNTY, WISCONSIN.

ORDERED BY: REALTY WORLD-KEITH JOHNSON
P. O. BOX 727
TWIN LAKES, WISCONSIN
53181

I HEREBY CERTIFY THAT I HAVE SURVEYED THE ABOVE DESCRIBED
PROPERTY AND THAT THE ABOVE MAP IS A TRUE REPRESENTATION
THEREOF AND SHOWS THE SIZE AND LOCATION OF THE PROPERTY,
ITS EXTERIOR BOUNDARIES, THE LOCATION OF ALL VISIBLE STRUCTURES
AND DIMENSIONS OF ALL PRINCIPAL BUILDINGS THEREON, BOUNDARY
FENCES, APPARENT EASEMENTS, ROADWAYS AND VISIBLE ENCROACH-
MENTS, IF ANY, TO THE BEST OF MY KNOWLEDGE AND BELIEF.

THIS SURVEY IS MADE FOR THE USE OF THE PRESENT OWNERS OF
THE PROPERTY AND ALSO THOSE WHO PURCHASE, MORTGAGE OR
GUARANTEE THE TITLE THERETO WITHIN ONE (1) YEAR FROM DATE
HEREOF.

Robert M. Baerenwald
ROBERT M. BAERENWALD
WISCONSIN REGISTERED LAND SURVEYOR, S-1508

DATE April 16, 1990 JOB NO. 2453

NOTE: THIS IS NOT A CERTIFIED COPY UNLESS SEALED.

MPLH 00130

118-958