


KOLB LAND CONSULTING, INC.
LAND SURVEYING • SUBDIVIDING • LAND PLANNING

LAKE GENEVA, WISCONSIN 53147

TELEPHONE (414) 248-3697

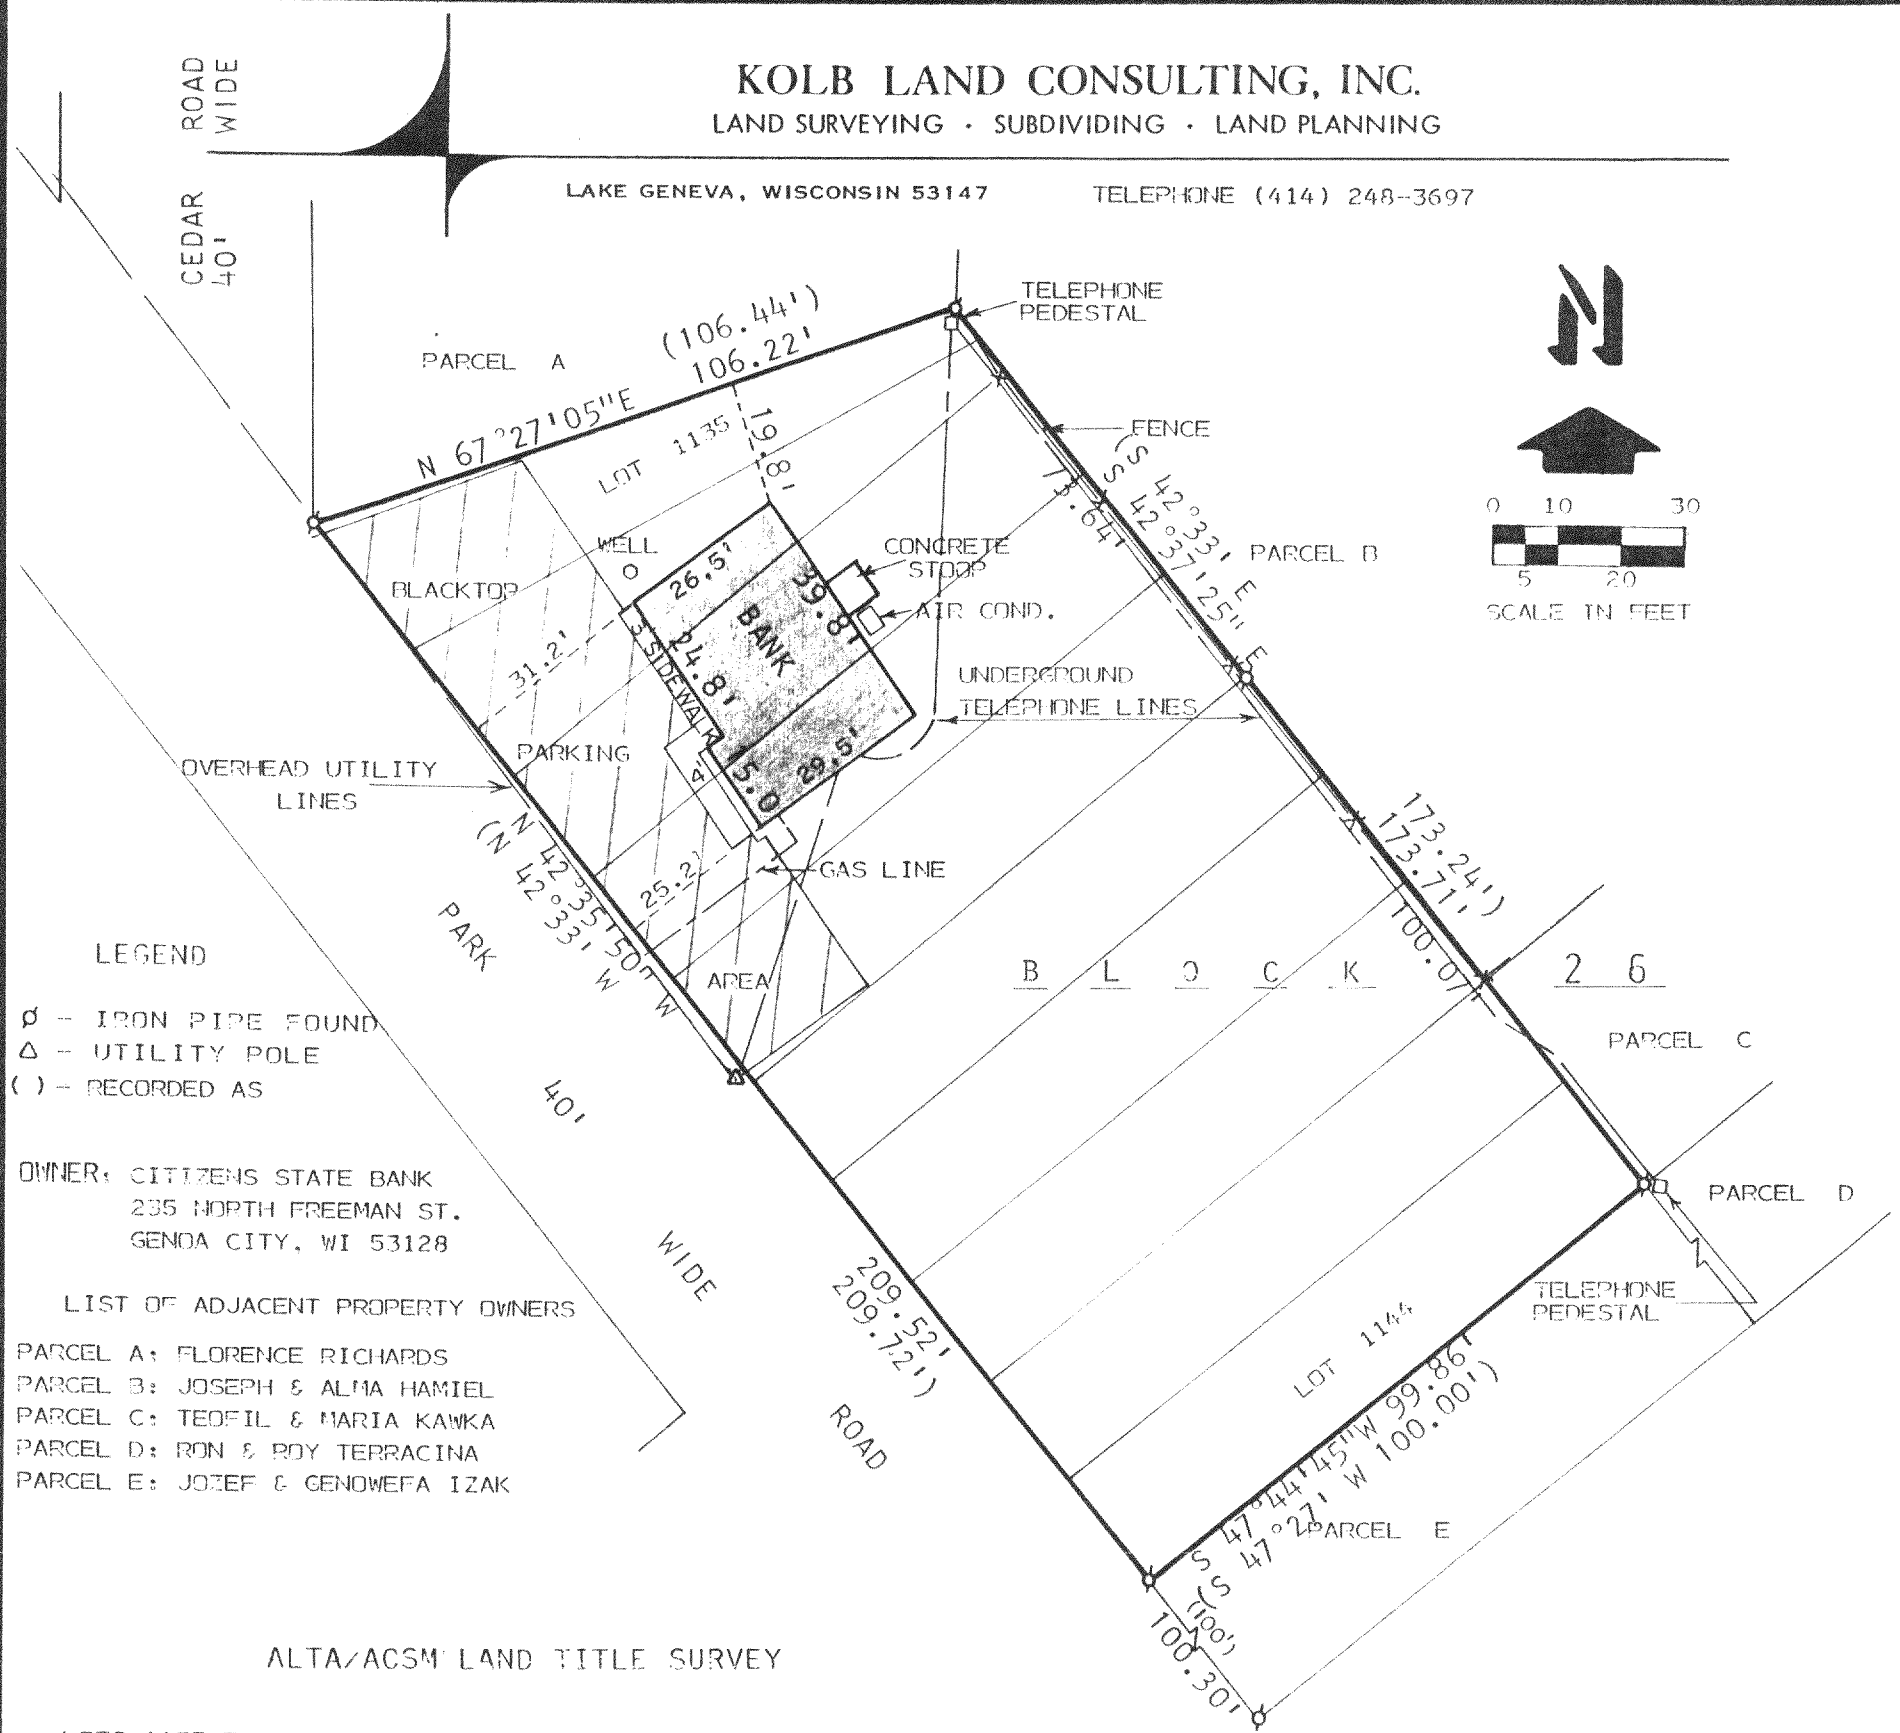

- LEGEND
- ⊙ - IRON PIPE FOUND
 - Δ - UTILITY POLE
 - () - RECORDED AS

OWNER: CITIZENS STATE BANK
235 NORTH FREEMAN ST.
GENOA CITY, WI 53128

- LIST OF ADJACENT PROPERTY OWNERS
- PARCEL A: FLORENCE RICHARDS
 - PARCEL B: JOSEPH & ALMA HAMIEL
 - PARCEL C: TEOFIL & MARIA KAWKA
 - PARCEL D: RON & ROY TERRACINA
 - PARCEL E: JOZEF & GENOWEFA IZAK

ALTA/ACSM LAND TITLE SURVEY


LOTS 1135 THRU 1144, BLOCK 26, SECTION 1 OF PELL LAKE SUBDIVISION,
T 1 N, R 18 E, TOWN OF BLOOMFIELD, WALWORTH COUNTY, WISCONSIN.

NOTE: THE SOUTHEAST LINE OF BLOCK 26 IS ASSUMED AS N 47°27' E
AS SHOWN ON THE ORIGINAL PLAT OF SECTION 1 OF PELL LAKE
SUBDIVISION.

NOTE: THE BANK BUILDING ON THIS PARCEL IS CONSTRUCTED OF BRICK,

I HEREBY CERTIFY TO CITIZENS STATE BANK AND
CHICAGO TITLE INSURANCE CO.:
THIS IS TO CERTIFY THAT THIS MAP OR PLAT AND
THE SURVEY ON WHICH IT IS BASED WERE MADE IN
ACCORDANCE WITH "MINIMUM STANDARD DETAIL
REQUIREMENTS FOR ALTA/ACSM LAND TITLE
SURVEYS," JOINTLY ESTABLISHED AND ADOPTED BY
ALTA AND ACSM MEETS THE ACCURACY REQUIREMENT
OF A CLASS B SURVEY, AS DEFINED THEREIN.

NOTE: THIS SURVEY IS NOT VALID UNLESS THE
SURVEYOR'S SIGNATURE IS IN RED.

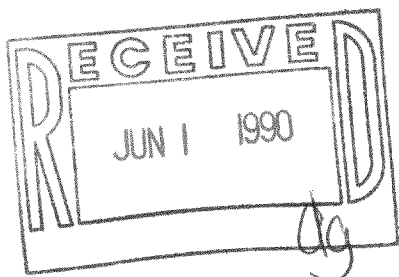

WISCONSIN REGISTERED LAND SURVEYOR, S- 187
DATE FEBRUARY 21, 1990