



414-728-6737

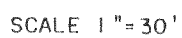


♂ - IRON PIPE FOUND
 ● - IRON ROD FOUND
 ○ - IRON ROD SET
 () - RECORDED AS

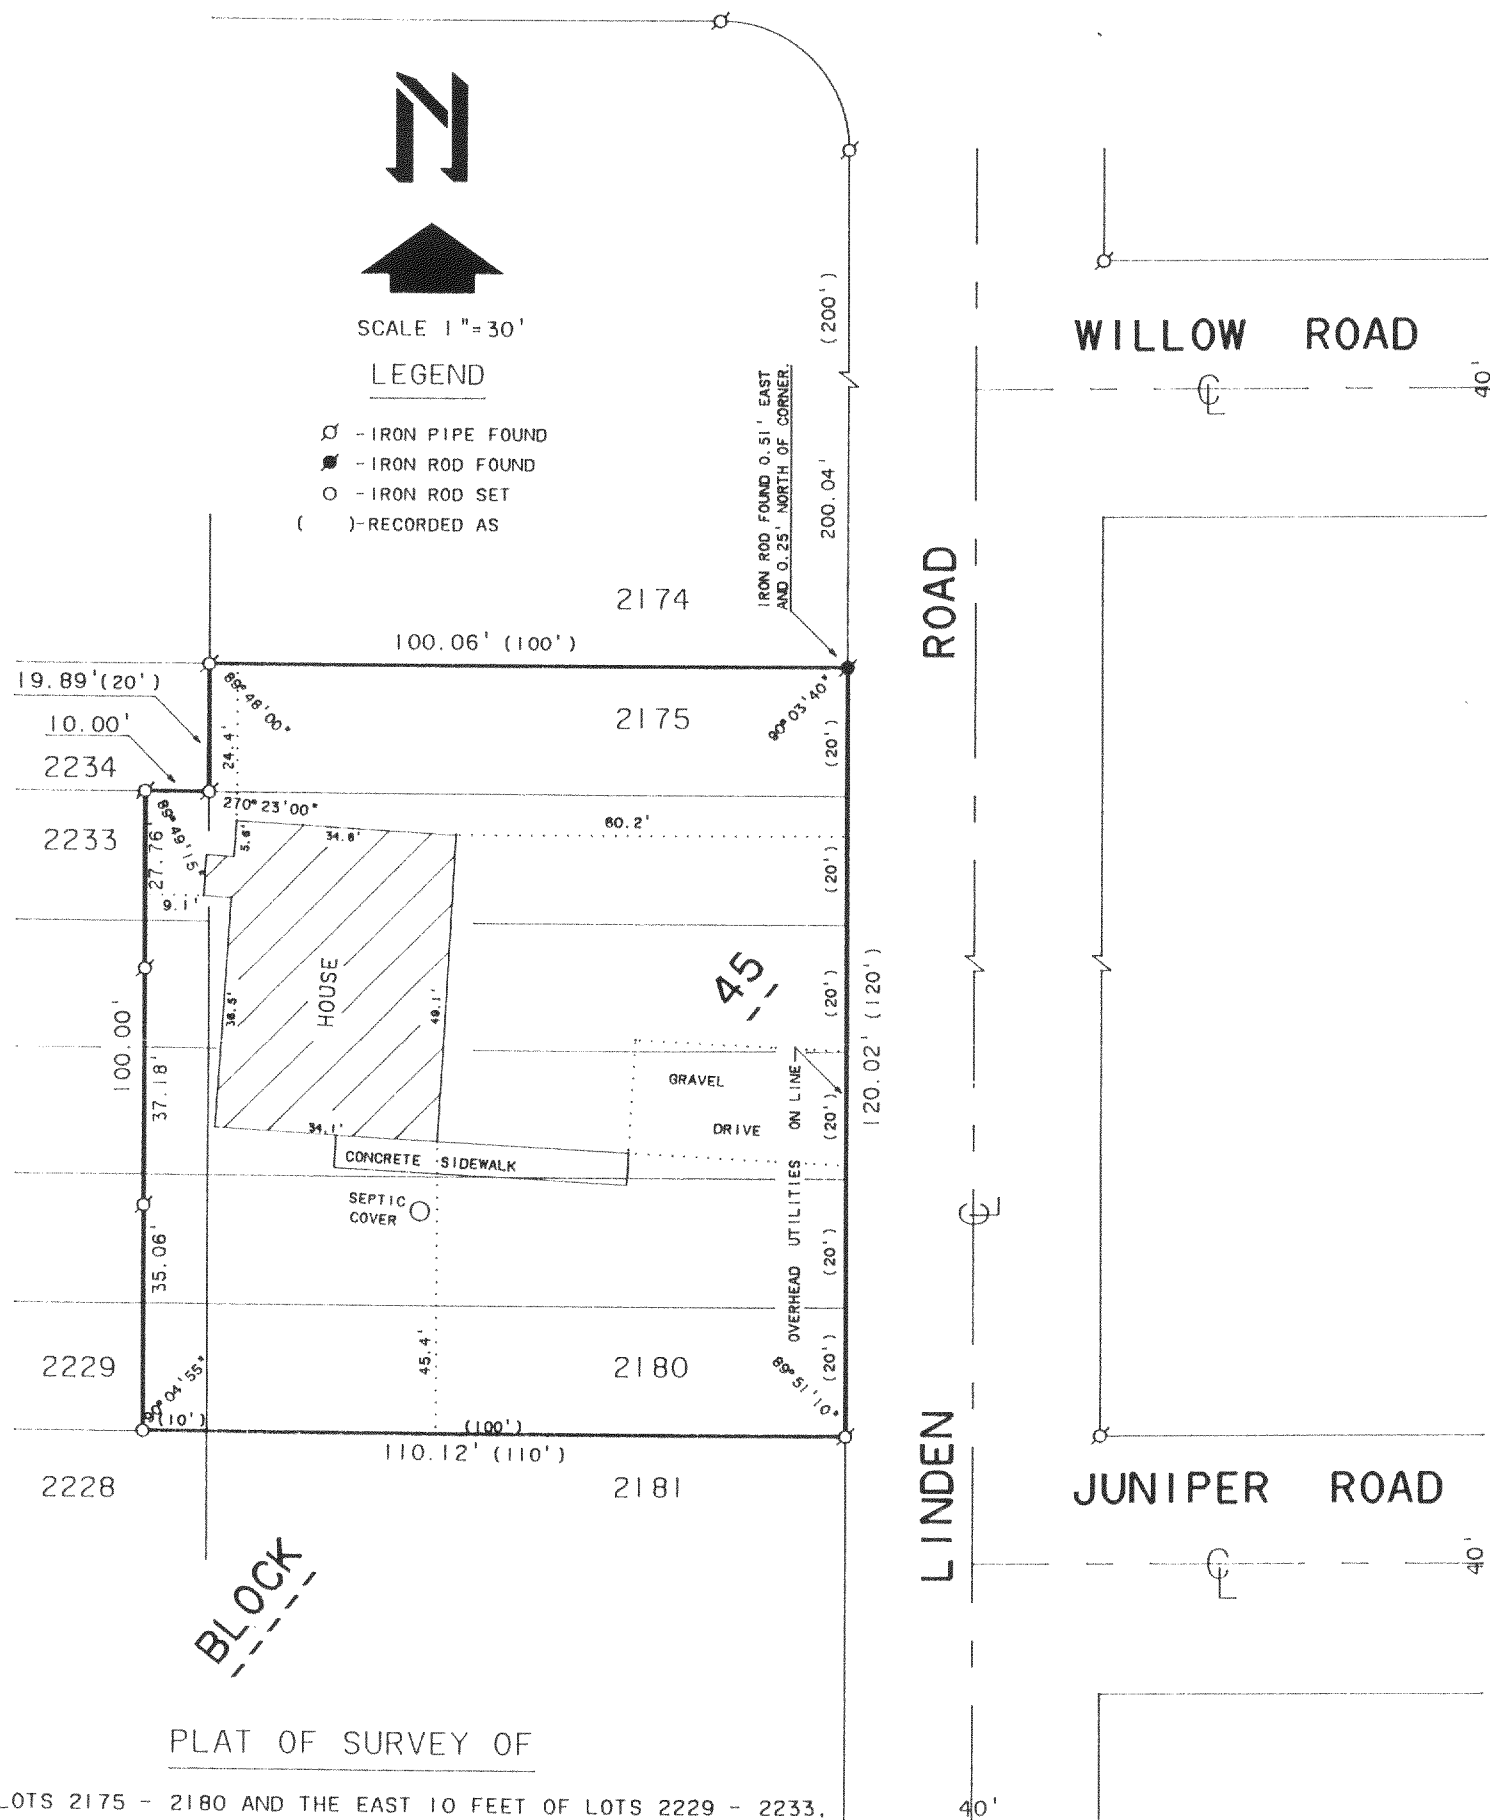

LOTS 2175 - 2180 AND THE EAST 10 FEET OF LOTS 2229 - 2233,
BLOCK 45, PELL LAKE SUBDIVISION, TNRIBE, WALWORTH
COUNTY, WISCONSIN.

ORDERED BY: THE PROPERTY SHOP
P.O. BOX 446
PELL LAKE, WI. 53157

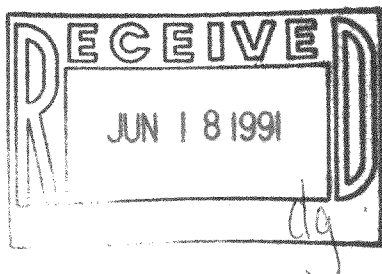

I HEREBY CERTIFY THAT I HAVE SURVEYED THE ABOVE DESCRIBED PROPERTY AND THAT THE ABOVE MAP IS A TRUE REPRESENTATION THEREOF AND SHOWS THE SIZE AND LOCATION OF THE PROPERTY, ITS EXTERIOR BOUNDARIES, THE LOCATION OF ALL VISIBLE STRUCTURES AND DIMENSIONS OF ALL PRINCIPAL BUILDINGS THEREON, BOUNDARY FENCES, APPARENT EASEMENTS, ROADWAYS AND VISIBLE ENCROACHMENTS, IF ANY, TO THE BEST OF MY KNOWLEDGE AND BELIEF.

THIS SURVEY IS MADE FOR THE USE OF THE PRESENT OWNERS OF THE PROPERTY, AND ALSO THOSE WHO PURCHASE, MORTGAGE, OR GUARANTEE THE TITLE THERETO WITHIN ONE (1) YEAR FROM DATE HEREOF.

DAVID F. ABELL

WISCONSIN REGISTERED LAND SURVEYOR, S-1596

December 7, 1990

DATE _____ JOB NUMBER - 90227

NOTE: THIS IS NOT A CERTIFIED COPY UNLESS SEALED.

118-992

MPL $\phi\phi 45\phi$