

LOTS 6724, 6725, 6726, 6727, AND 6728, BLOCK 145, PELL LAKE SUBDIVISION SECTION 4, LOCATED IN THE NORTH HALF OF SECTION 15, T. 1 N., R. 18 E., OF THE 4TH P. M., TOWNSHIP OF BLOOMFIELD, WALWORTH COUNTY, WISCONSIN.


SCALE: 1" = 30'

O = IRON PIPE STAKE FOUND.

BEARINGS ARE THOSE OF RECORDED PLAT.

Dated at Burlington, this 30th day.

cl SEPT 19 91
John F. Degen
John F. Degen, Land Surveyor S 242
569 N. Pine St. Burlington, WI 53105

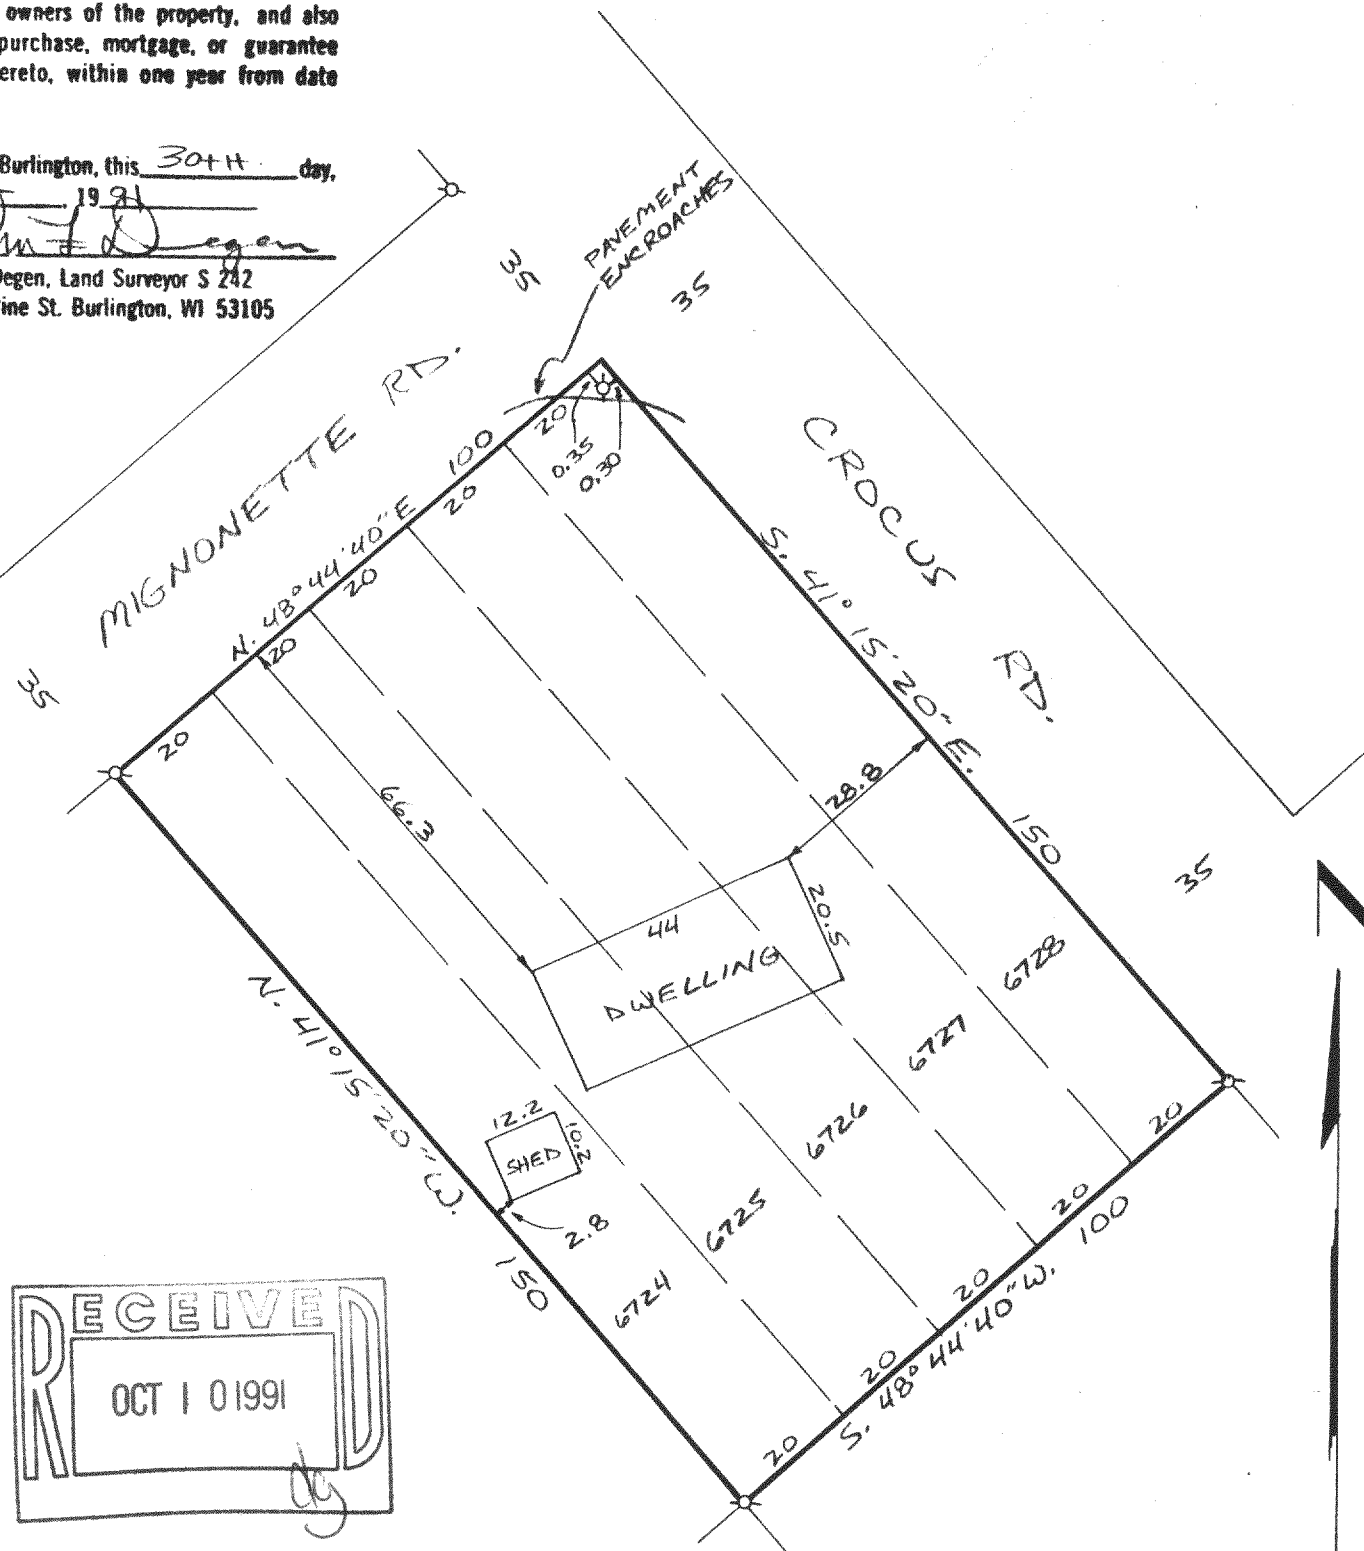

118-995

MPL 01467

16-E-1 #16